

15-129-10259-0000

STATE OF KANSAS
STATE CORPORATION COMMISSION

Give All Information Completely
Make Required Affidavit
Mail or Deliver Report to:
Conservation Division
State Corporation Commission
211 No. Broadway
Wichita, Kansas

WELL PLUGGING RECORD

Morton County. Sec. 28 Twp. 34S Rge. (E) 41 (W)

Location as "NE/CNW/SW" or footage from lines G NW NE

Lease Owner Cities Service Petroleum Company

Lease Name Gerber "A" Well No. 1

Office Address Box 1147 Liberal, Kansas

Character of Well (completed as Oil, Gas or Dry Hole) _____

Date well completed 8-6- 19 61

Application for plugging filed 8-6- 19 61

Application for plugging approved 8-6- 19 61


Plugging commenced 8-6- 19 61

Plugging completed 8-6- 19 61

Reason for abandonment of well or producing formation Dry Hole

If a producing well is abandoned, date of last production _____ 19 _____

Was permission obtained from the Conservation Division or its agents before plugging was commenced? Yes - verbal

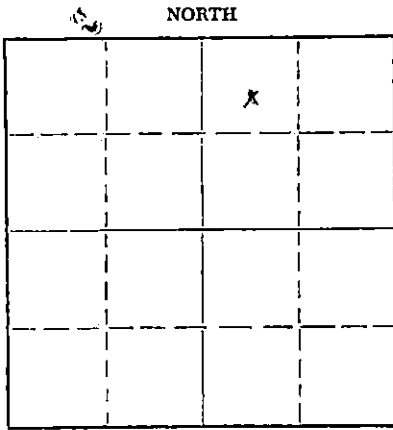

Locate well correctly on above Section Plat

Name of Conservation Agent who supervised plugging of this well Mr. Frank Broadfoot

Producing formation Dry Hole Depth to top _____ Bottom _____ Total Depth of Well 5285 Feet

Show depth and thickness of all water, oil and gas formations.

OIL, GAS OR WATER RECORDS

CASING RECORD

FORMATION	CONTENT	FROM	TO	SIZE	PUT IN	PULLED OUT
L. Morrow	Water	5038	5060	8 5/8	1453	None
U. Morrow	Water	4905	4920			

Describe in detail the manner in which the well was plugged, indicating where the mud fluid was placed and the method or methods used in introducing it into the hole. If cement or other plugs were used, state the character of same and depth placed, from _____ feet to _____ feet for each plug set.

- Heavy rotary mud from 5285-5050
- Spot 50 sx pozmix 5050-4902
- Heavy mud from 4902-3367
- Spot 25 sx pozmix 3367-3293
- Heavy mud 3293-2461
- 25 sx pozmix 2461-2387
- Heavy mud from 2387-1430
- 15 sx pozmix 1430-1386
- Heavy mud 1386- 35'
- 10 sx pozmix 35' to surface

RECEIVED
STATE CORPORATION COMMISSION
AUG 22 1961
8-22-1961
CONSERVATION DIVISION
Wichita, Kansas

(If additional description is necessary, use BACK of this sheet)

Name of Plugging Contractor Halliburton Co.
Address Duncan, Oklahoma

STATE OF Kansas, COUNTY OF Seward, ss.
W. L. Boosa (employee of owner) or (~~owner~~) of the above-described well, being first duly sworn on oath, says: That I have knowledge of the facts, statements, and matters herein contained and the log of the above-described well as filed and that the same are true and correct. So help me God.

(Signature) W. L. Boosa
Box 1147 Liberal, Kansas W. L. Boosa
(Address)

SUBSCRIBED AND SWORN TO before me this 7th day of August, 1961

My commission expires 5-23-65 J. T. Mabrey Notary Public