


STATE OF KANSAS  
STATE CORPORATION COMMISSION

WELL PLUGGING RECORD

Give All Information Completely  
Make Required Affidavit  
Mail or Deliver Report to:  
Conservation Division  
State Corporation Commission  
800 Bitting Building  
Wichita, Kansas

OR  
FORMATION PLUGGING RECORD Strike out upper line when reporting plugging of formations.

Sumner County, Sec. 17 Twp. 30S Rge. 1W (E) (W)  
Location as "NE $\frac{1}{4}$ NW $\frac{1}{4}$ SW $\frac{1}{4}$ " or footage from lines NW NW NE $\frac{1}{4}$   
Lease Owner Allison and Hatfield  
Lease Name Voils Well No. 1  
Office Address 11715 Brown Bldg., Wichita, Kansas  
Character of Well (completed as Oil, Gas or Dry Hole) Dry hole  
Date well completed 6-30-50 19  
Application for plugging filed 6-30-50 19  
Application for plugging approved 6-30-50 19  
Plugging commenced 6-30-50 19  
Plugging completed 6-30-50 19  
Reason for abandonment of well or producing formation Dry hole  
If a producing well is abandoned, date of last production 19  
Was permission obtained from the Conservation Division or its agents before plugging was commenced? Yes

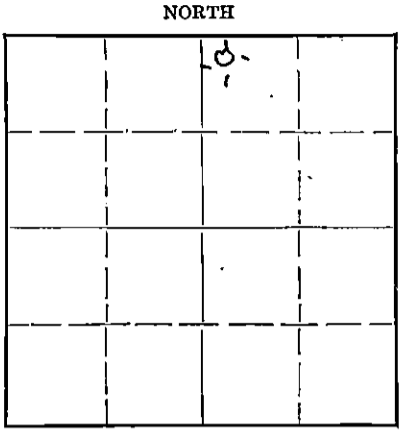

Locate well correctly on above Section Plat

Name of Conservation Agent who supervised plugging of this well W. G. Buffington  
Producing formation None Depth to top Bottom Total Depth of Well 4025 Feet  
Show depth and thickness of all water, oil and gas formations.

OIL, GAS OR WATER RECORDS

CASING RECORD

Formation	Content	From	To	Size	Put In	Pulled Out
Lime	Water	30	58	8-5/8	315'	0

Describe in detail the manner in which the well was plugged, indicating where the mud fluid was placed and the method or methods used in introducing it into the hole. If cement or other plugs were used, state the character of same and depth placed, from feet to feet for each plug set.

Came half way out of hole and loaded hole with heavy mud/ Hole was filled to 315' with heavy mud and bottom plug set at 320', 15 sacks cement placed on top of plug. Hole then filled with heavy mud to 15' and 10 sacks of cement placed on top plug to surface.

RECEIVED  
Conservation Div.  
JUL 5 1950  
STATE CORPORATION COMMISSION  
KANSAS

(If additional description is necessary, use BACK of this sheet)

Correspondence regarding this well should be addressed to Address

STATE OF Kansas, COUNTY OF Sedgwick, ss.

J. A. Allison (employee of owner) or (owner or operator) of the above-described well, being first duly sworn on oath, says: That I have knowledge of the facts, statements, and matters herein contained and the log of the above-described well as filed and that the same are true and correct. So help me God.

(Signature) J. A. Allison

715 Brown Building, Wichita, Kansas (Address)

SUBSCRIBED AND SWORN to before me this 30 day of June, 19 50

My commission expires July 22, 1953

Notary Public  
PLUGGING  
FILE SEC-17T 30R1W  
BOOK PAGE 13 LINE 39

LOCATION: NW NW NE  $\frac{1}{4}$

SEC: 17; TWP: 30S; RGE: 1W;

FARM: W. T. VOILS #1

CASING RECORD:

COMPANY: A. D. ALLISON & CO., INC.,  
and HARRY HATFIELD

8-5/8 315'

CONTR: A. D. ALLISON & CO., INC.,

COMM: 6/11/50 COMP: 6/30/50

PROD: DRY HOLE

FORMATION

DEPTH

Lime	55
Shale and lime	150
Lime and shale	250
Shale and lime	305
Anhydrite	315
Lime and shale	715
Shale and lime-	755
Sandy lime	780
Shale and lime	880
Lime and shale	1215
Shale and lime	1330
Shale and shells	1655
Shale	1740
Lime	1845
Lime and shale	2025
Shale	2075
Shale and shells	2125
Shale	2220
Lime	2242
Lime and shale	2450
Shale	2582
Sand	2715
Sand and shale	2750
Shale	2912
Lime	3175
Lime and shale	3250
Shale and shells	3310
Shale	3365
Shale and lime	3515
Chat	3529
Cherty lime	3581
Lime and shale	3660
Lime	3850
Shale	3878
Sand	3933
Shale and sand	3940
Sandy shale & cherty lime	3988
Cherty lime	3994
Lime	4025
TOTAL DEPTH	4025

TOPS:

Stalnaker sand	2581
Kansas City	2911
Mississippi	3515
Simpson sand	3878
Arbuckle	3977

D S T 3890

Recovered 50 feet muddy water,  
1000 lbs. bottom hole pressure  
in one hour.

3905. Recovered 100 feet drilling  
mud in one hour.

RECEIVED  
Conservation Div.  
JUL 5 - 1950  
STATE CORPORATION  
COMMISSION  
KANSAS

PLUGGING  
FILE SEC 17 - T 30R 1W  
BOOK PAGE 13 LINE 39

Certified true copy of Drillers log.  
By J. R. Allison