

STATE OF KANSAS
STATE CORPORATION COMMISSION


Form CP-4

Give All Information Completely
Make Required Affidavit
Mail or Deliver Report to:
Conservation Division
State Corporation Commission
P. O. Box 17027
Wichita, Kansas 67217
NORTH

WELL PLUGGING RECORD

Sedgwick County, Sec. 24 Twp. 29S Rge. (E) 3W (W)

Location as "NE/CNWSW" or footage from lines C NE NW
Lease Owner Mack Oil Co.
Lease Name Lemon Well No. 1
Office Address 812 Union Center, Wichita, KS 67202
Character of Well (completed as Oil, Gas or Dry Hole) dry hole
Date well completed 7-11-73 19
Application for plugging filed 7-11-73 19
Application for plugging approved 7-11-73 19
Plugging commenced 7-11-73 19
Plugging completed 7-11-73 19
Reason for abandonment of well or producing formation dry hole

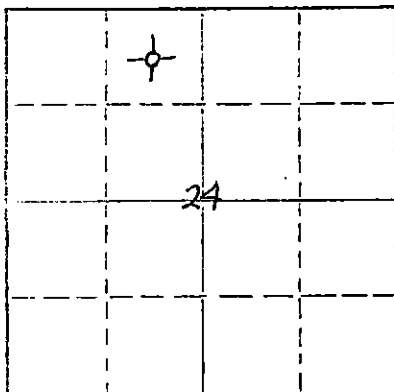

Locate well correctly on above Section Plat

If a producing well is abandoned, date of last production 19
Was permission obtained from the Conservation Division or its agents before plugging was commenced? yes

Name of Conservation Agent who supervised plugging of this well Ted Dewey
Producing formation _____ Depth to top _____ Bottom _____ Total Depth of Well 4132' Feet
Show depth and thickness of all water, oil and gas formations.

OIL, GAS OR WATER RECORDS

CASING RECORD

FORMATION	CONTENT	FROM	TO	SIZE	PUT IN	PULLED OUT
				8 5/8"	237'	

Describe in detail the manner in which the well was plugged, indicating where the mud fluid was placed and the method or methods used in introducing it into the hole. If cement or other plugs were used, state the character of same and depth placed, from _____ feet to _____ feet for each plug set.


Plugged at 230' w/25 sx. Halli. plug & 1/2 sx. hulls
40' w/10 sx. same

RECEIVED
STATE CORPORATION COMMISSION
JUL 17 1973
CONSERVATION DIVISION
Wichita, Kansas

(If additional description is necessary, use BACK of this sheet)
Name of Plugging Contractor Thomas Drlg. Co.
Address P. O. Box 400, Duncan, OK 73533

STATE OF Kansas COUNTY OF Sedgwick SS.
J. Corry Tinsmon (employee of owner) or (owner or operator) of the above-described well, being first duly sworn on oath, says: That I have knowledge of the facts, statements, and matters herein contained and the log of the above-described well as filed and that the same are true and correct. So help me God.

(Signature) J. Corry Tinsmon by NCL
812 Union Center, Wichita, KS 67202
(Address)

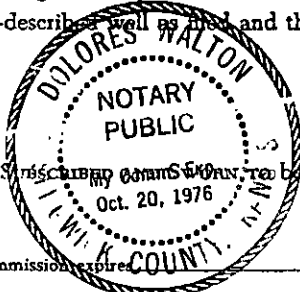

My commission expires before me this 13th day of July 19 73
Dolores Walton Notary Public

MACK OIL COMPANY
 Duncan, Oklahoma
 73533

DRILLERS WELL LOG

#1 Lemon C NE NW - Section 24-29S-3W
 Sedgwick County, Kansas
 Commenced R. D. 7-3-73 Elevation: 1295' K.B., 1288' G.L.
 Completed R. D. 7-11-73 Dry & Abandoned
 Rotary Total Depth: 4132' Contractor: Thomas Drilling Co.

STRATA	DEPTH
Shale & Sand	0 - 240
Shale & Shells	240 - 360
Shale & Lime	360 - 805
Shell & Shale	805 - 1040
Shale & Lime	1040 - 1580
Lime & Shale	1580 - 2430
Lime	2430 - 2694
Lime & Shale	2694 - 3046
Lime	3046 - 4132 RTD

RECEIVED
 STATE CORPORATION COMMISSION
 JUL 17 1973
 CONSERVATION DIVISION
 Wichita, Kansas

I hereby certify that the above is a true and correct log of said well as reflected by the daily drilling reports.

MACK OIL COMPANY

BY J. Corry Tinsmon by JCL
 J. Corry Tinsmon

Signed and sworn to in my presence
 this 16th day of July, 1973, by
 J. Corry Tinsmon, representative
 of Mack Oil Company

Eva Jean Burright
 Eva Jean Burright, Notary Public

My commission expires:
 December 1, 1976

