

STATE OF KANSAS
STATE CORPORATION COMMISSION

WELL PLUGGING RECORD

SUMNER

County. Sec. 22 Twp. 30s Rge. 1w (E) (W)

Location as "NE/CNW/SW" or footage from lines C NW NE

Lease Owner Thomas E. Sullivan and others

Lease Name NIXON Well No. 2

Office Address 218 Plaza Theatre Bldg., Kansas City 12, Missouri

Character of Well (completed as Oil, Gas or Dry Hole) Oil Well

Date well completed January 1, 1949 19

Application for plugging filed June 24 19 58

Application for plugging approved July 10 19 58

Plugging commenced June 27 19 58

Plugging completed June 27 19 58

Reason for abandonment of well or producing formation

Because of lack of production in commercial quantities.

If a producing well is abandoned, date of last production May 19 58


Was permission obtained from the Conservation Division or its agents before plugging was commenced? YES

Give All Information Completely

Make Required Affidavit

Mail or Deliver Report to:
Conservation Division
State Corporation Commission
211 No. Broadway
Wichita, Kansas

NORTH

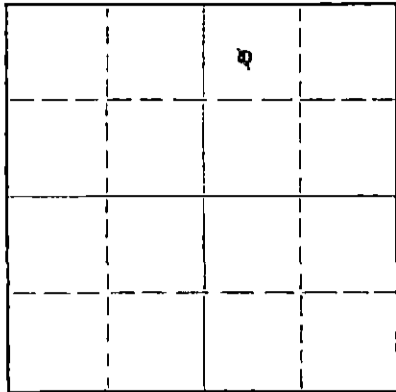

Locate well correctly on above Section Plat

Name of Conservation Agent who supervised plugging of this well Eugene H. Graham

Producing formation Simpson Depth to top 3893 Bottom 3900 Total Depth of Well 3900 Feet

Show depth and thickness of all water, oil and gas formations.

OIL, GAS OR WATER RECORDS

CASING RECORD

FORMATION	CONTENT	FROM	TO	SIZE	PUT IN	PULLED OUT
Simpson		3104		5 1/2"	3883	3104

Describe in detail the manner in which the well was plugged, indicating where the mud fluid was placed and the method or methods used in introducing it into the hole. If cement or other plugs were used, state the character of same and depth placed, from _____ feet to _____ feet for each plug set.

5 sacks in bottom of hole
15 sacks in bottom of surface
10 sacks on top

Set plug in bottom. Set plug at 240 with 10' Rock Bridge and 15 sacks of cement - Mud to 30 ft. - 10' Rock Bridge and 10 sacks of cement to surface. Cut pipe 6" below ground level.

(If additional description is necessary, use BACK of this sheet)

Name of Plugging Contractor Red Top Drilling Company
Address Winfield, Kansas

STATE OF MISSOURI, COUNTY OF JACKSON, ss.
Thomas E. Sullivan (employee of owner) or (owner or operator) of the above-described

well, being first duly sworn on oath, says: That I have knowledge of the facts, statements, and matters herein contained and the log of the above-described well as filed and that the same are true and correct. So help me God.

(Signature) Thomas E. Sullivan

SUBSCRIBED AND SWORN TO before me this 24th day of JULY, 19 58

My commission expires January 18, 1961.

(Address) Service K. Leach Notary Public.

PLUGGING
FILE SEC 22 T. 30 R 1W
BOOK PAGE 113 Line 27

RECEIVED
JUL 26 1958
COMMISSION
CONSERVATION DIVISION
Wichita, Kansas

N. J. SULLIVAN EST ABD ET AL
NIXON WELL # 2

Sec. 22 T. 30 S R. 1 W
O NW NW
Sumner County, Kansas
Production 1st 24 hrs 1050
Elevation 1270

Total depth with rotary 3900'
Drilling comm 12-3-48
Drilling comp 1-1-49
Drilling contractor H. W. Williams
Began Producing 1-9-49
Gravity 46

Casing
10" 325' (275 sk Cement)
5 1/2" 3895' (150 " ")

FIGURES INDICATE BOTTOM OF FORMATIONS

Soil & lime	65	
clay & lime	150	Shale water 45 to 65'
lime	200	
lime & shale	225	
lime hard	355	
lime	450	
lime & shale	490	
shale & shells	600	
red rock	615	
lime	620	
lime & shale	750	
shale & shells	845	
lime	860	
shale & lime	1865	
lime	1965	
lime & shale	2055	
shale	2200	
shale & lime	2649	
sand (Layton)	2677	
shale & lime	2888	Top Kansas City 2888
lime	2937	
lime & shale streaks	3012	
limy shale	3019	
lime porous	3044	
limy shale	3047	
lime	3052	
limy shale	3055	
lime (porous to 3070 dense to	3094	
shale	3097	
lime	3116	
lime & shale streaks	3491	
cherty lime	3496	Top Miss. lime 3491
Chat	3524	
lime dense	3555	
chat	3569	
lime	3586	
shaly & cherty lime	3673	
lime dense	3820	
shale	3832	
lime	3844	
lime & limy shale	3893	Top Kinderhook 3872
dolomite	3895	
sand	3900	Top sand 3894 Show oil

Total Depth 3900 Flowed well for 45 minutes through 2" choke on 1-9-49 and made 57 barrels of 45 gravity oil

RECEIVED
STATE OIL & GAS COMMISSION

JUL 2 1958

COMMISSION DIVISION
Wichita, Kansas

PLUGGING
FILE SEC. 22 T. 30 R. 1 W
BOOK PAGE 113 LINE 27