

WELL PLUGGING RECORD

STATE OF KANSAS STATE CORPORATION COMMISSION


Give All Information Completely Make Required Affidavit Mail or Deliver Report to: Conservation Division State Corporation Commission 800 Bitting Building Wichita, Kansas

FORMATION PLUGGING RECORD

Strike out upper line when reporting plugging of formations.

Sumner County. Sec. 22 Twp 30S Rge. 1 (E) (W)

Location as "NE 1/4 NW 1/4 SW 1/4" or footage from lines C S/2 NW SE Lease Owner PETROLEUM, INC. 100 Derby Bldg. Wichita, Kansas. Lease Name Hurst Well No. 2 Office Address 100 Derby Building, Wichita 2, Kansas Character of Well (completed as Oil, Gas or Dry Hole) Dry Hole Date well completed November 23, 1949 Application for plugging filed December 5, 1949 Application for plugging approved November 29, 1949 Plugging commenced November 23, 1949 Plugging completed November 23, 1949 Reason for abandonment of well or producing formation

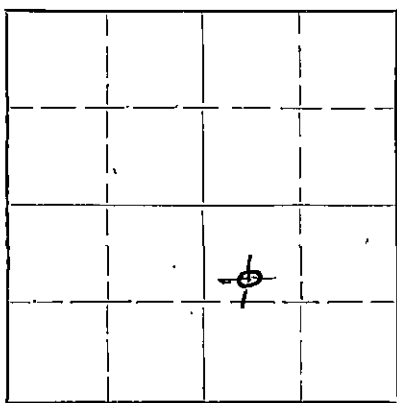

Locate well correctly on above Section Plat

If a producing well is abandoned, date of last production 19 Was permission obtained from the Conservation Division or its agents before plugging was commenced? yes

Name of Conservation Agent who supervised plugging of this well Jack Melland, 1111 N. Main, Hutchinson, Ks.

Producing formation Depth to top Bottom Total Depth of Well 4020 Feet

Show depth and thickness of all water, oil and gas formations.

OIL, GAS OR WATER RECORDS

CASING RECORD

Table with 7 columns: Formation, Content, From, To, Size, Put In, Pulled Out. Row 1: 8 5/8, 320'

Describe in detail the manner in which the well was plugged, indicating where the mud fluid was placed and the method or methods used in introducing it into the hole. If cement or other plugs were used, state the character of same and depth placed, from feet to feet for each plug set.

Hole was filled with heavy mud from 4020' to bottom of surface casing. 15 sacks of cement in bottom of casing and heavy mud to top of casing and 10 sacks of cement in top of surface casing.

RECORDED 12-6-1949 DEC 6 - 1949 STATE OF KANSAS

(If additional description is necessary, use BACK of this sheet)

Correspondence regarding this well should be addressed to PETROLEUM, INC. Address 100 Derby Building, Wichita 2, Kansas

STATE OF KANSAS, COUNTY OF SEDGWICK, ss.


(employee of owner) or (owner or operator) of the above-described well, being first duly sworn on oath, says: That I have knowledge of the facts, statements, and matters herein contained and the log of the above-described well as filed and that the same are true and correct. So help me God.

(Signature) Eric J. Jager 100 Derby Building, Wichita 2, Kansas. (Address)

SUBSCRIBED AND SWORN to before me this 5th day of December, 1949

Notary Public Marjorie Bradshaw

My commission expires October 27, 1952

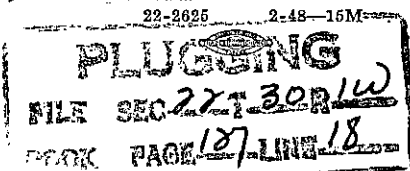

WELL LOG HURST NO. 2

Petroleum, Inc., Lease Owner

Section 22, Twp1 30S, Rge. 1W

Melland Drilling Co., Contractor

Location: C S/2 NW SE

Rotary Total Depth: 4020'

County: Sumner, Kansas

Commenced: October 13, 1949

Production: Dry Hole

Completed: November 23, 1949

Elevation: 1271 D.F.

Casing: 340' 8 5/8"

Figures below indicate bottom of formation

120 Surface Clay
 180 Clay & Shells
 220 Lime & Gypsum
 220 Shale & Shells
 295 Shale
 322 Lime & Shells
 350 Shale & Anhydrite
 600 Shale & Shells
 795 Lime (broken)
 905 Shale & Shells
 1140 Shale & Lime
 1405 Shale & Shells
 2240 Lime & Shale
 2255 Shale
 2355 Shale & Shells
 2740 Lime & Shale
 2815 Shale & Shells
 2901 Lime & Shale
 2963 Lime
 3087 Lime Sh. streaks
 3130 Lime
 3280 Lime & Shale
 3421 Shale & Shells
 3438 Shale & Lime

3510 Shale
 3533 Lime: "Miss."
 3549 Lime & Chert
 3549 Lime
 3620 Lime (broken)
 3642 Lime
 3850 Shale & Shells
 3875 Lime & Shale
 3915 Shale
 3928 Sand
 3975 Sand & Shale
 4006 Shale
 4015 Lime

Tops

Kansas City 2900
 Mississippian 3512
 Kinderhook SH. 3852
 Simpson: 3910
 Arbuckle: 4006
 R.T.D. 4020

RECEIVED

DEC 6 - 1949

STATE COMMISSION
KANSAS

I hereby certify that this is a true and correct log of the above mentioned well.

PETROLEUM, INC.

Eric H. Jager

STATE OF KANSAS
SS.
SEDGWICK COUNTY

PLUGGING

Subscribed to and sworn to before me, a Notary Public in said County and State this 2nd day of December, 1949.

Margaret Bradshaw
Notary Public

My Commission Expires: October 27, 1952