


STATE OF KANSAS  
STATE CORPORATION COMMISSION

WELL PLUGGING RECORD

Give All Information Completely  
Make Required Affidavit  
Mail or Deliver Report to  
Conservation Division  
State Corporation Comm.  
245 North Water  
Wichita, KS 67202

Kingman County, Sec. 25 Twp. 29S Rge. 5W E/W  
Location as "NE/CNW $\frac{1}{4}$ SW $\frac{1}{4}$ " or footage from lines  
NW SW NW

Lease Owner Sanders Oil Company  
Lease Name Gosch Well No. 1  
Office Address 910 Sutton Place Wichita, Kansas  
Character of Well (Completed as Oil, Gas or Dry Hole)  
dry hole

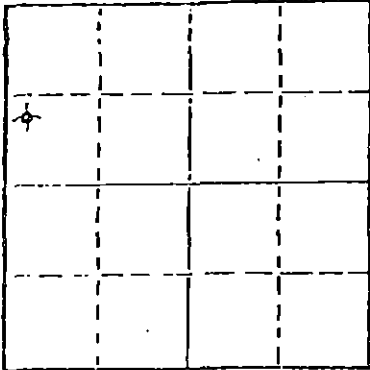

Locate well correctly on above  
Section Plot

Date Well completed 11-21-79 19  
Application for plugging filed 11-21-79 19  
Application for plugging approved 11-21-79 19  
Plugging commenced 11-21-79 19  
Plugging completed 11-21-79 19  
Reason for abandonment of well or producing formation

If a producing well is abandoned, date of last production 19

Was permission obtained from the Conservation Division or  
its agents before plugging was commenced? yes

Name of Conservation Agent who supervised plugging of this well Bill Owen  
Producing formation Depth to top Bottom Total Depth of Well 4640  
Show depth and thickness of all water, oil and gas formations.

OIL, GAS OR WATER RECORDS

CASING RECORD

FORMATION	CONTENT	FROM	TO	SIZE	PUT IN	PULLED OUT
Surface		0	.247	8 5/8"	247	0

Describe in detail the manner in which the well was plugged, indicating where the mud fluid  
was placed and the method or methods used in introducing it into the hold. If cement or other  
plugs were used, state the character of same and depth placed, from \_\_\_\_\_ feet to  
\_\_\_\_\_ feet for each plug set.

40 Sx @ 240', bridge &  $\frac{1}{2}$  Sx hulls 10 Sx cement @ 40'  
5 Sx in rathole

11-24-1979  
12-7-1980

(If additional description is necessary, use BACK of this sheet)

Name of Plugging Contractor Sun Cementing

STATE OF Kansas COUNTY OF Sedgwick, ss.  
Timothy E. Brandt (employee of owner) or (owner or operator)  
of the above-described well, being first duly sworn on oath, says: That I have knowledge of  
the facts, statements, and matters herein contained and the log of the above-described well  
as filed and that the same are true and correct. So help me God.

(Signature) Timothy E. Brandt  
1104 Douglas Building Wichita, Kansas  
(Address)

SUBSCRIBED AND SWORN TO before me this 28th day of November, 1979

Mari Jane Nungesser  
Notary Public.

My commission expires May 18, 1982



15-095-20882-0000


KANSAS

WELL COMPLETION REPORT AND DRILLER'S LOG

API No. 15 - 095 - 20,882  
 County Number

S. 25 T. 29S R. 5W E  
 W  
 Loc. NW SW NW  
 County Sedgwick  
 640 Acres  
 N

Operator Sanders Oil Company  
 Address 910 Sutton Place Wichita, Kansas 67202  
 Well No. 1 Lease Name Gosch  
 Footage Location 1650 feet from (N) (S) line 330 feet from (E) (W) line  
 Principal Contractor Brandt Drilling Co., Inc. Geologist Jim Dilts  
 Spud Date 11-9-79 Date Completed 11-21-79 Total Depth 4640 P.B.T.D.  
 Directional Deviation Oil and/or Gas Purchaser

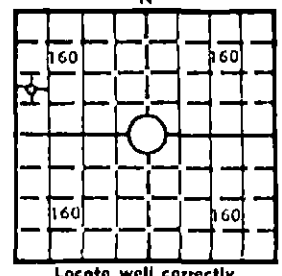

Elev.: Gr. 1416 Gr  
 DF \_\_\_\_\_ KB \_\_\_\_\_

CASING RECORD

Report of all strings set — surface, intermediate, production, etc.

Purpose of string	Size hole drilled	Size casing set (In O.D.)	Weight lbs/ft.	Setting depth	Type cement	Sacks	Type and percent additives
Surface	12 1/4"	8 5/8	24#	247'	common	200	2% Gel

LINER RECORD

PERFORATION RECORD

Top, ft.	Bottom, ft.	Sacks cement	Shots per ft.	Size & type	Depth interval

TUBING RECORD

Size	Setting depth	Packer set at

ACID, FRACTURE, SHOT, CEMENT SQUEEZE RECORD

Amount and kind of material used	Depth interval treated

INITIAL PRODUCTION

Date of first production \_\_\_\_\_ Producing method (flowing, pumping, gas lift, etc.) \_\_\_\_\_  
 RATE OF PRODUCTION PER 24 HOURS  
 Oil \_\_\_\_\_ bbls. Gas \_\_\_\_\_ MCF Water \_\_\_\_\_ bbls. Gas-oil ratio \_\_\_\_\_ CFPB  
 Disposition of gas (vented, used on lease or sold) \_\_\_\_\_ Producing interval(s) \_\_\_\_\_

INSTRUCTIONS: As provided in KCC Rule 82-2-125, within 90 days after completion of a well, one completed copy of this Drillers Log shall be transmitted to the State Geological Survey of Kansas, 4150 Monroe Street, Wichita, Kansas 67209. Copies of this form are available from the Conservation Division, State Corporation Commission, 245 No. Water, Wichita, Kansas 67202. Phone AC 316-522-2206. If confidential custody is desired, please note Rule 82-2-125. Drillers Logs will be on open file in the Oil and Gas Division, State Geological Survey of Kansas, Lawrence, Kansas 66044.

Operator Sanders Oil Company DESIGNATE TYPE OF COMP.: OIL, GAS, DRY HOLE, SWDW, ETC.: dry hole

Well No. 1 Lease Name Gosch

S 25 T29S R 5W E Kingman, County, Kansas

**WELL LOG**  
 Show all important zones of porosity and contents thereof; cored intervals, and all drill-stem tests, including depth interval tested, cushion used, time tool open, flowing and shut-in pressures, and recoveries.  
 SHOW GEOLOGICAL MARKERS, LOGS RUN, OR OTHER DESCRIPTIVE INFORMATION.

FORMATION DESCRIPTION, CONTENTS, ETC.	TOP	BOTTOM	NAME	DEPTH
Shale & sand	0	250		
Shale & gypsum	250	380		
Salt & shale	380	1040		
Lime	1040	1300		
Shale & lime	1300	1520		
Lime & cherty lime	1520	1750		
Sand & silty sand	1750	1780		
Lime	1780	2500		
Lime & shale	2500	2846		
Shale, black	2846	2855		
Shale & sandy shale	2855	3202		
Sand, porous	3202	3250		
Shale & sandy shale	3250	3390		
Lime	3390	3515		
Shale, black	3515	3522		
Shale & lime	3522	3598		
Lime, hard dense	3598	3800		
Shale, lime	3800	4010		
Lime & cherty lime	4010	4346		
Shale	4336	4458		
Sand & dolomite	4458	4587		
Dolomite	4587	4640		
RTD	4640			

USE ADDITIONAL SHEETS, IF NECESSARY, TO COMPLETE WELL RECORD.

Date Received \_\_\_\_\_  
 Signature \_\_\_\_\_  
 General Manager \_\_\_\_\_  
 Title \_\_\_\_\_  
 November 28, 1979 \_\_\_\_\_  
 Date \_\_\_\_\_