

15-191-00617-0000

STATE OF KANSAS  
STATE CORPORATION COMMISSION

WELL PLUGGING RECORD

Give All Information Completely  
Make Required Affidavit  
Mail or Deliver Report to:  
Conservation Division  
State Corporation Commission  
800 Biting Building  
Wichita, Kansas

Summer

County, Sec. 24 Twp. 30S Rge. 1 (W)

Location as "NE/CNW/SW" or footage from lines NE 1/4 SE 1/4 SW 1/4

Lease Owner Sherrod & Apperson

Lease Name Parker Well No. 1

Office Address 215 1/2 East Sixth, Tulsa 3, Oklahoma

Character of Well (completed as Oil, Gas or Dry Hole) Dry Hole

Date well completed July 1 19 54


Application for plugging filed July 1 19 54

Application for plugging approved July 1 19 54

Plugging commenced July 1 19 54

Plugging completed July 1 19 54

Reason for abandonment of well or producing formation Dry Hole

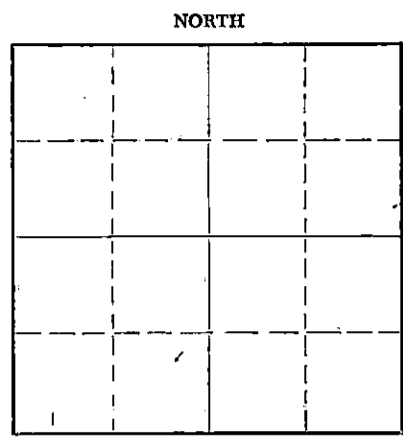

Locate well correctly on above Section Plat

If a producing well is abandoned, date of last production 19

Was permission obtained from the Conservation Division or its agents before plugging was commenced? Yes

Name of Conservation Agent who supervised plugging of this well W. G. Buffington

Producing formation Depth to top Bottom Total Depth of Well 3985 Feet

Show depth and thickness of all water, oil and gas formations.

OIL, GAS OR WATER RECORDS

CASING RECORD

FORMATION	CONTENT	FROM	TO	SIZE	PUT IN	PULLED OUT

Describe in detail the manner in which the well was plugged, indicating where the mud fluid was placed and the method or methods used in introducing it into the hole. If cement or other plugs were used, state the character of same and depth placed, from feet to feet for each plug set.

Filled hole with heavy mud from 3985 feet to 275 feet. Set Halliburton wooden plug at 275 feet. Dumped 1/2 sack hulls and 15 sacks cement on plug and filled hole to 40 feet. Set second Halliburton wooden plug at 40 feet and filled to bottom of cellar with 1/2 sack of hulls and 10 sacks of cement.

RECEIVED

7-2-1954

(If additional description is necessary, use BACK of this sheet)

Name of Plugging Contractor Barnett Drilling, Inc.

Address 623 First National Bank Building, Wichita, Kansas

STATE OF Kansas, COUNTY OF Sedgwick, ss. contractor F. R. Stubblefield

(employee of owner or owner or operator) of the above-described well, being first duly sworn on oath, says: That I have knowledge of the facts, statements, and matters herein contained and the log of the above-described well as filed and that the same are true and correct. So help me God.

(Signature) F. R. Stubblefield

623 First National Bank Bldg., Wichita, Kansas (Address)

SUBSCRIBED AND SWORN TO before me this 6th day of July, 19 54

Mildred J. Willis Notary Public.

My commission expires February 27, 1956

24-2675-B 2-52-20M

PLUGGING FILE SEC 24 T 30 R 1W BOOK PAGE 45 LINE 29

BARNETT DRILLING, INC.

LOG OF PARKER WELL NO. 1

NE $\frac{1}{4}$  SE $\frac{1}{4}$  SW $\frac{1}{4}$  SECTION 24-30S-1W, SUMNER COUNTY, KANSAS

Commenced: 6-10-54

Completed: 7-1-54

<u>Formation</u>	<u>From</u>	<u>To</u>	<u>Remarks</u>
Surface Clay	0	35	
Sand	35	45	
Shale and Shells	45	287	Set 8 5/8" surface pipe at 287 feet, cemented with 225 sacks.
Lime and Shale	287	1265	
Shale and Shells	1265	1655	
Shale	1655	1743	
Lime and Shale	1743	2465	
Shale and Sand	2465	2630	
Lime	2630	2790	
Shale	2790	2853	
Lime	2853	3190	
Lime and Shale	3190	3240	
Lime and Shale	3240	3435	
Lime	3435	3795	
Lime and Shale	3795	3875	
Simpson (Core)	3875	3898	
Sand	3898	3916	
Sand and Shale	3916	3960	
Shale	3960	3969	
Chert and Lime	3969	3985	
Total Depth		3985	Dry and Abandoned

Certificate

I, F. R. Stubblefield, of Barnett Drilling, Inc., certify that to the best of my knowledge and belief, the above is a true and correct log of the Parker Well No. 1, located in the NE $\frac{1}{4}$  SE $\frac{1}{4}$  SW $\frac{1}{4}$  of Section 24-30S-1W, Sumner County, Kansas.

*F. R. Stubblefield*

Subscribed and sworn to before me, in and for the County of Sedgwick, State of Kansas, this 6th day of July, 1954.

RECEIVED  
STATE CORPORATION COMMISSION  
JUL 2 1954  
CONSERVATION DIVISION  
WICHITA, KANSAS

*Walter J. Willis*

My commission expires February 27, 1956.

**PLUGGING**  
FILE SEC 24 T 30 R 1W  
BOOK PAGE 45 LINE 29