


Give All Information Completely
Make Required Affidavit
Mail - Deliver Report to:
Conservation Division
State Corporation Commission
P. O. Box 17027
Wichita, Kansas 67217
NORTH

WELL PLUGGING RECORD

Sumner County, Sec. 24 Twp. 30S Rge. 1W (E) (W)

Location as "NE/CNW/SW" or footage from lines NW SE NW.
Lease Owner Vincent Oil Corporation
Lease Name Turney Well No. 1
Office Address 901 E Union Center, Wichita, Kansas 67202
Character of Well (completed as Oil, Gas or Dry Hole) D & A
Date well completed May 4, 19 75
Application for plugging filed May 4, 19 75
Application for plugging approved May 4, 19 75
Plugging commenced May 4, 19 75
Plugging completed May 4, 19 75
Reason for abandonment of well or producing formation D & A

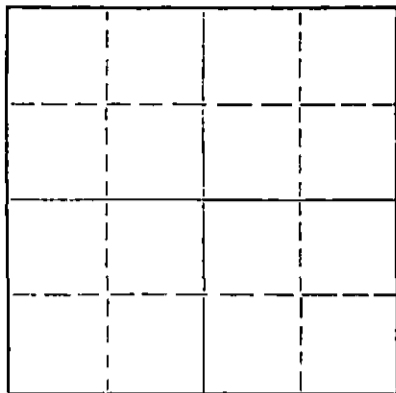

Locate well correctly on above Section Plat

If a producing well is abandoned, date of last production 19
Was permission obtained from the Conservation Division or its agents before plugging was commenced? Yes

Name of Conservation Agent who supervised plugging of this well Mr. Eugene H. Graham
Producing formation Depth to top Bottom Total Depth of Well 3863 Feet

Show depth and thickness of all water, oil and gas formations.

OIL, GAS OR WATER RECORDS

CASING RECORD

FORMATION	CONTENT	FROM	TO	SIZE	PUT IN	PULLED OUT
				8-5/8"	285'	-0-

Describe in detail the manner in which the well was plugged, indicating where the mud fluid was placed and the method or methods used in introducing it into the hole. If cement or other plugs were used, state the character of same and depth placed, from feet to feet for each plug set.

Hole Plugged by Halliburton w/35 sx. @ 250'
15 sx. @ 40' & 1/2 sack hulls.

RECEIVED
STATE CORPORATION COMMISSION

5-12-75

CONSERVATION DIVISION
WICHITA, KANSAS

(If additional description is necessary, use BACK of this sheet)

Name of Plugging Contractor Red Tiger Drilling Company
Address 1720 Wichita Plaza, Wichita, Kansas 67202

STATE OF Kansas, COUNTY OF Sedgwick, ss.
Linda H. Dickens (employee of owner) or (owner or operator) of the above-described well, being first duly sworn on oath, says: That I have knowledge of the facts, statements, and matters herein contained and the log of the above-described well as filed and that the same are true and correct. So help me God.

(Signature) Linda H. Dickens
1720 Wichita Plaza, Wichita, Kansas 67202
(Address)

Subscribed and Sworn to before me this 7th day of May, 19 75



December 28, 1977

J. Ann Drennan
Notary Public.

12-28-1977

DRILLERS LOG

No. 1 Turney

CASING RECORD:

8-5/8" @ 285'
w/185 sx. cnt.

COMPANY:

Vincent Oil Corp.

CONTRACTOR:

Red Tiger Drilling Co.

COMMENCED:

April 23, 1975

COMPLETED:

May 4, 1975

DESCRIPTION:

NW SE NW
24-305-1W
Sumner County,
Kansas

TOTAL DEPTH: 3863'

ELEVATION: 1228' K.B.

<u>FORMATION</u>	<u>FROM</u>	<u>TO</u>	<u>REMARKS</u>
Sand	0	35	
Shale & Lime	35	287	
Lime	287	1210	
Lime & Shale	1210	2650	
Lime	2650	3207	
Shale & Lime	3207	3293	
Lime	3293	3863	

I certify that this is a true and correct copy of the above log to the best of my knowledge.

RED TIGER DRILLING COMPANY


Linda H. Dickens
Linda H. Dickens

Subscribed and sworn to before me this 7th day of May, 1975.

D'Ann Drennan
Notary Public

My Commission Expires:

December 28, 1977

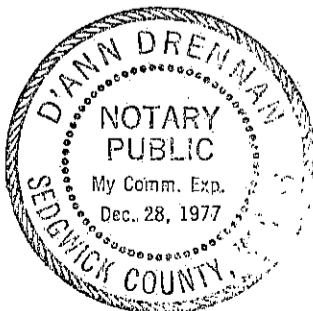

RECEIVED
MAY 10 1975
DIVISION