


STATE OF KANSAS
STATE CORPORATION COMMISSION

WELL PLUGGING RECORD

Give All Information Completely
Make Required Affidavit
Mail or Deliver Report to:
Conservation Division
State Corporation Commission
800 Bitting Building
Wichita, Kansas

Harper County, Sec. 6 Twp. 30 Rge. 6 NE-NE-NE
(E) (W)

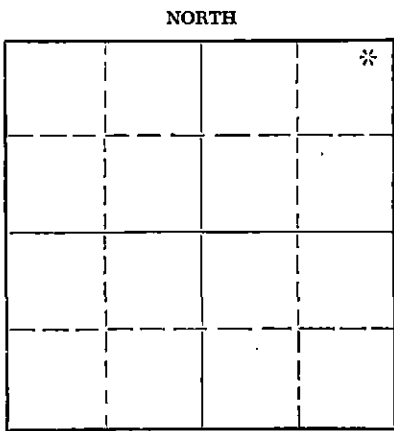

Locate well correctly on above
Section Plat

Location as "NE/CNW&SWK" or footage from lines 330'
Lease Owner Mull Drilling Co., Inc.
Lease Name Allender Well No. 1
Office Address 670 North 4th Nat. Bank Bldg. Wichita, Kansas
Character of Well (completed as Oil, Gas or Dry Hole) Dry Hole
Date well completed 7-26 1958
Application for plugging filed 7-26 1958
Application for plugging approved 7-26 1958
Plugging commenced 7-26 9:00 A. M. 1958
Plugging completed 7-26 11:00 A. M. 1958
Reason for abandonment of well or producing formation Dry Hole

If a producing well is abandoned, date of last production 19
Was permission obtained from the Conservation Division or its agents before plugging was commenced? Yes Frank Broadfoot St. John, Kansas

Name of Conservation Agent who supervised plugging of this well Frank Broadfoot St. John, Kansas
Producing formation none Depth to top 0 Bottom 4143 Total Depth of Well 4143 Feet
Show depth and thickness of all water, oil and gas formations.

OIL, GAS OR WATER RECORDS

CASING RECORD

FORMATION	CONTENT	FROM	TO	SIZE	PUT IN	PULLED OUT

Describe in detail the manner in which the well was plugged, indicating where the mud fluid was placed and the method or methods used in introducing it into the hole. If cement or other plugs were used, state the character of same and depth placed, from feet to feet for each plug set.

Well was plugged with 30 sacks common cement. #1 plug @ 180' with 20 sacks cement on top. #2 plug @ 40' with 10 sacks cement on top. Job was supervised by state pluggers.

(If additional description is necessary, use BACK of this sheet)

Name of Plugging Contractor none
Address

STATE OF KANSAS, COUNTY OF SEDGWICK, ss.
Joseph O. Butts (employee of owner) or (owner or operator) of the above-described well, being first duly sworn on oath, says: That I have knowledge of the facts, statements, and matters herein contained and the log of the above-described well as filed and that the same are true and correct. So help me God.

(Signature) Joseph O. Butts
705 Kansas. Medicine Lodge, Kansas (Address)

SUBSCRIBED AND SWORN TO before me this 28th day of July, 19 58

Ethel Zimmerman
Ethel Zimmerman Notary Public.

My commission expires January 28, 1961

PLUGGING
FILE SEC. 6 T. 30 R. 6W.
BOOK PAGE 120 LINE 19

8-1-58

ROTARY DRILLERS LOG

COMPANY : Mull Drilling Co., Inc. Et Al ROTARY DRILLING COMMENCED: 7-14-58
 Wichita, Kansas

CONTRACTOR : Mull Drilling Co., Inc. ROTARY DRILLING COMPLETED: 7-26-58
 Wichita, Kansas

GASING RECORD : Set 8 5/8" @ 200', cemented LOCATION: ALLENDER #1
 with 150 sacks cement. NE NE NE of 6-30S-6W
 Kingman County, Kansas

(Figures indicate bottom of formation - measurements from top of Rotary Bushing)

475'	Red Bed
960'	Shale & Shells
1425'	Shale & Lime
1700'	Lime
2495'	Lime & Shale
2595'	Lime
3602'	Lime & Shale
3853'	Lime
4026'	Lime & Shale
4110'	Conglomerate & Chert
4143'	Mississippi - Total Depth (D & A)

I hereby certify that this is a true and correct copy of the above log to the best of my knowledge.


MULL DRILLING COMPANY, INC.

BY *[Signature]* ASST. TREAS.
JOSEPH B. BRUNGARDT, JR.

STATE OF KANSAS)
) SS
 COUNTY OF SEDGWICK)

Subscribed and sworn to before me this 31st day of July, 1958.

Ethel Zimmerman
 NOTARY PUBLIC

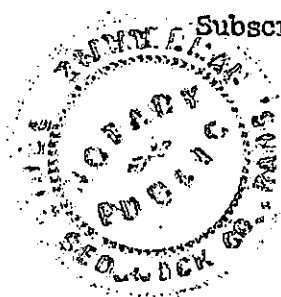

MY COMMISSION EXPIRES: JANUARY 28, 1961

PLUGGING
 FILE SEC 6 T.30. R.6W
 BOOK PAGE 120 LINE 19

RECEIVED
 STATE OF KANSAS COMMISSION
 AUG 1 1958
 REGISTRATION DIVISION
 STATE OF KANSAS