


STATE OF KANSAS
STATE CORPORATION COMMISSION

Form CP-4

Give All Information Completely
Make Required Affidavits
Call or Deliver Report to:
Conservation Division
State Corporation Commission
212 No. Market
Wichita, Kansas

WELL PLUGGING RECORD

Kingman County. Sec. 6 Twp. 30S Rgc. 6W ~~XX~~ (W)
Location as "NE/CNW/KSWK" or footage from lines C SW SE
Lease Owner D. R. Lauck Oil Company, Inc.
Lease Name Cessna Well No. 1
Office Address 301 S. Broadway, Wichita, Kansas
Character of Well (completed as Oil, Gas or Dry Hole) Dry Hole
Date well completed September 24, 1966
Application for plugging filed September 24, 1966
Application for plugging approved September 24, 1966
Plugging commenced September 24, 1966
Plugging completed September 24, 1966
Reason for abandonment of well or producing formation Dry Hole

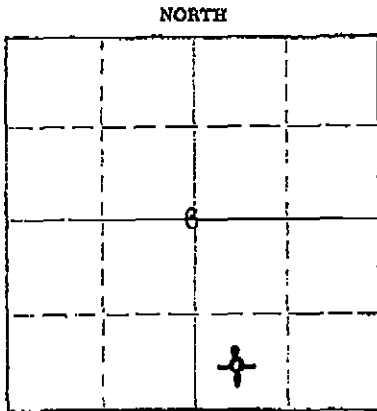

Locate well correctly on above
Section Plat

If a producing well is abandoned, date of last production _____ 19____
Was permission obtained from the Conservation Division or its agents before plugging was commenced? Yes

Name of Conservation Agent who supervised plugging of this well Herman Justus
Producing formation _____ Depth to top _____ Bottom _____ Total Depth of Well 4550 Feet
Show depth and thickness of all water, oil and gas formations.

OIL, GAS OR WATER RECORDS

CASING RECORD

FORMATION	CONTENT	FROM	TO	SIZE	PUT IN	PULLED OUT
		0'	249'	8-5/8"	249'	None

Describe in detail the manner in which the well was plugged, indicating where the mud fluid was placed and the method or methods used in introducing it into the hole. If cement or other plugs were used, state the character of same and depth placed, from _____ feet to _____ feet for each plug set.

4550'-240' Mud
240'-236' Plug
236'-196' Cement, 23 sacks
196'-40' Mud
40'-36' Plug
36'-6' Cement, 10 sacks (Bottom of cellar)

(If additional description is necessary, use BACK of this sheet)

Name of Plugging Contractor Lauck Drilling Company, Incorporated
Address 301 S. Broadway, Wichita, Kansas

STATE OF KANSAS, COUNTY OF SEDGWICK, ss.

John H. Knightley (employee of owner) or (owner or operator) of the above-described well, being first duly sworn on oath, says: That I have knowledge of the facts, statements, and matters herein contained and the log of the above-described well as filed and that the same are true and correct. So help me God.

(Signature)

John H. Knightley

301 S. Broadway, Wichita, Kansas
(Address)

SUBSCRIBED AND SWORN TO before me this 29th day of September, 1966.

Stella J. Lipps

Notary Public.

My commission expires March 12, 1967