


Give All Information Completely  
Make Required Affidavit  
Mail or Deliver Report to:  
Conservation Division  
State Corporation Commission  
211 No. Broadway  
Wichita, Kansas

WELL PLUGGING RECORD

Kingman County, Sec. 5 Twp. 30S Rge. (E) 6 (W)  
Location as "NE/CNW&SW&" or footage from lines C NE-SE  
Lease Owner Monsanto Company  
Lease Name Cessna Well No. 1  
Office Address 3545 NW 58th St., Okla. City, Ok. 73112  
Character of Well (completed as Oil, Gas or Dry Hole) Dry Hole  
Date well completed April 26, 19 79  
Application for plugging filed 19  
Application for plugging approved 19  
Plugging commenced April 6 19 79  
Plugging completed April 6 19 79  
Reason for abandonment of well or producing formation Non Commercial

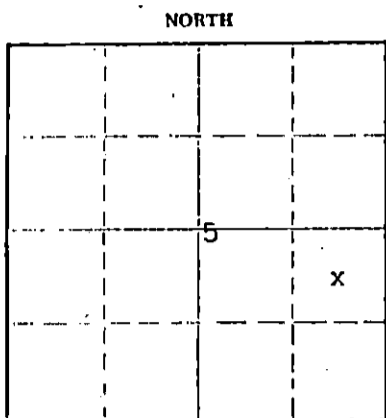

Locate well correctly on above Section Plat

If a producing well is abandoned, date of last production 19  
Was permission obtained from the Conservation Division or its agents before plugging was commenced? Yes, verbal approval received on April 2, 1979

Name of Conservation Agent who supervised plugging of this well Bill Owen  
Producing formation Depth to top Bottom Total Depth of Well 4210 Feet  
Show depth and thickness of all water, oil and gas formations.

OIL, GAS OR WATER RECORDS

CASING RECORD

FORMATION	CONTENT	FROM	TO	SIZE	PUT IN	PULLED OUT
Kansas City - DST	Salt Water	3585'	3632'	8-5/8	264	0
Mississippi -DST	Show gas	4078'	4094'			
Mississippi -DST	Salt Water	4094'	4210'			

Describe in detail the manner in which the well was plugged, indicating where the mud fluid was placed and the method or methods used in introducing it into the hole. If cement or other plugs were used, state the character of same and depth placed, from feet to feet for each plug set.

- (1) 40 sack plug above Mississippi from 3950' to 4050'.
- (2) 40 sack plug above Kansas City from 3350' to 3450'.
- (3) 40 sack plug below surface casing from 240' to 340'.
- (4) 12 sack plug in surface casing from 4' to 40'.
- (5) Cut off casing 4' below ground level, plugged rat hole with 4 sacks and plugged water well with 1 sack. Plugging completed 7:30 AM 4-6-79.

RECEIVED  
STATE CORPORATION COMMISSION  
APR 11 1979  
CONSERVATION DIVISION  
Wichita, Kansas

(If additional description is necessary, use BACK of this sheet)

Name of Plugging Contractor Dowell  
Address Box 816, Great Bend, Kansas 67530

STATE OF Oklahoma, COUNTY OF Oklahoma, ss.  
Bruce E. Roll (employee of owner) or (owner of operation) of the above-described well, being first duly sworn on oath, says: That I have knowledge of the facts, statements, and matters herein contained and the log of the above-described well as filed and that the same are true and correct. So help me God.

(Signature) Bruce E. Roll  
3545 N. W. 58th St., Okla. City, Ok. 73112  
(Address)

SUBSCRIBED AND SWORN to before me this 6th day of April, 19 79

My commission expires September 13, 1979

Notary Public.

KANSAS DRILLERS LOG

COMPANY Monsanto Company

SEC. 5 T. 30S R. 6W

FARM Cessna NO. 1

LOC. C-NE SE

COUNTY Kingman

ROTARY TOTAL DEPTH 4,210'

COMM. March 26, 1979

COMP. April 5, 1979

CONTRACTOR H-30, Inc. (Rig #3)

ISSUED April 12, 1979

CASING

10 3/4"

8 5/8" Set at 263' cemented w/225 sxs cement

5 1/2"

4 1/2"

ELEVATION 1,433'K.B.

FIGURES INDICATE BOTTOM OF FORMATIONS

Red Bed and Shale	107'
Sand and Shale	265'
Shale	319'
Red Bed and Shale	1,035'
Shale and Lime	1,400'
Shale	1,565'
Lime and Shale	1,905'
Shale and Lime	3,125'
Lime and Shale	4,210'
Rotary Total Depth	4,210'


I hereby certify the above and foregoing to be a true and correct log of the above described well as shown by the drilling reports.

H-30, Inc.

Dean Britting  
Dean Britting

State of Kansas }  
County of Sedgwick } ss:

Subscribed and Sworn to before me a Notary Public in and for said county and state this 12th day of April, 1979.

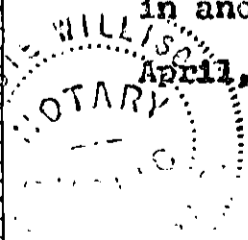

Elsie Willison  
Elsie Willison - Notary Public

My Commission Expires:  
July 25, 1982

RECEIVED  
STATE CORPORATION COMMISSION  
APR 13 1979  
CONSERVATION DIVISION  
Wichita, Kansas