

STATE OF KANSAS
STATE CORPORATION COMMISSION


Form CP-4

Give All Information Completely
Make Required Affidavit
Mail or Deliver Report to:
Conservation Division
State Corporation Commission
212 No. Market
Wichita, Kansas 67202

WELL PLUGGING RECORD

Kingman County, Sec. 7 Twp. 30 Rge. 6 (E) (W) x

Location as "NE/CNWSW" or footage from lines 200' So. C NW NW
Lease Owner Comet Petroleum Corporation
Lease Name Messenger Well No. #1
Office Address 200 West Douglas, Suite 500, Wichita, Kansas
Character of Well (completed as ~~Oil~~, Gas or Dry Hole)
Date well completed 19
Application for plugging filed 2-3-72 19
Application for plugging approved 19
Plugging commenced 2-7-72 19
Plugging completed 2-10-72 19
Reason for abandonment of well or producing formation

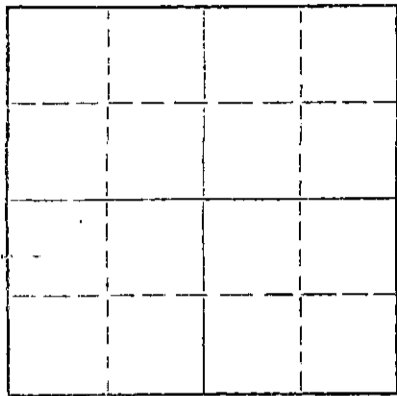

Locate well correctly on above
Section Plat

If a producing well is abandoned, date of last production 19
Was permission obtained from the Conservation Division or its agents before plugging was commenced?

Name of Conservation Agent who supervised plugging of this well G. R. Biberstein
Producing formation Depth to top Bottom Total Depth of Well 4104' Feet
Show depth and thickness of all water, oil and gas formations.

OIL, GAS OR WATER RECORDS

CASING RECORD

| FORMATION | CONTENT | FROM | TO | SIZE | PUT IN | PULLED OUT |
|-----------|---------|------|----|--------|--------|------------|
| | | | | 5 1/2" | 4090' | 3437.49' |
| | | | | 8 5/8" | 250' | |
| | | | | | | |
| | | | | | | |
| | | | | | | |
| | | | | | | |
| | | | | | | |

Describe in detail the manner in which the well was plugged, indicating where the mud fluid was placed and the method or methods used in introducing it into the hole. If cement or other plugs were used, state the character of same and depth placed, from feet to feet for each plug set.

Made bottom hole plug back with sand to 4080'. Mixed and dumped 5 sacks cement thru dump bailer.
Bridge hole from 250' - 240'. Plug with 4 yards ready-mix to base of cellar.

RECEIVED
STATE CORPORATION COMMISSION
FEB 1 1972
CONSERVATION DIVISION
Wichita, Kansas


(If additional description is necessary, use BACK of this sheet)

Name of Plugging Contractor Southwest Casing Pulling Co.
Address Box 364 Great Bend, Kansas

STATE OF Kansas, COUNTY OF Barton, ss.
Southwest Casing Pulling Co. (employee of owner) or (owner or operator) of the above-described well, being first duly sworn on oath, says: That I have knowledge of the facts, statements, and matters herein contained and the log of the above-described well as filed and that the same are true and correct. So help me God.

(Signature) W. C. Spencer Sec.
Box 364 Great Bend, Kansas
(Address)

Subscribed and sworn to before me this 10 day of February, 1972

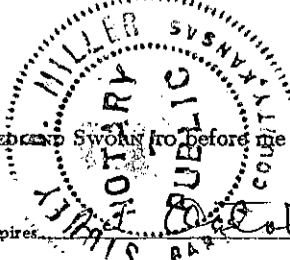

Sydney D. Miller
Notary Public.

My commission expires October 1972

WELL LOG
Messenger #1
C NW NW 7-30S-6W
Kingman County, Kansas

Name of Operator: Comet Petroleum Corp.
200 West Douglas
Wichita, Kansas 67200

Date Completed: July 19, 1971

| FROM | TO | |
|------|------|-------------------|
| 0 | 30 | Sand |
| 30 | 300 | Shale and Red bed |
| 300 | 857 | Shale |
| 857 | 3513 | Shale : Lime |
| 3513 | 4016 | Lime |
| 4016 | 4100 | Lime and Chert |
| 4100 | | Total Depth |

RECEIVED
STATE CORPORATION COMMISSION
FEB 7 1972
CONSERVATION DIVISION
Wichita, Kansas

STATE OF KANSAS

COUNTY OF BARTON ss

Gary L. Hawk, Secretary of Sweetman Drilling, Inc., being first duly sworn on oath says: That I have knowledge of the facts, statements, and matters herein contained and the log of the above described well as filed and that the same are true and correct.

Gary L. Hawk
Gary L. Hawk

Subscribed and sworn before me this 20th. day of July, 1971.

Mary Ann Schwamborn
Notary Public Barton County

My Commission Expires 7-10-73

