


WELL PLUGGING RECORD

Give All Information Completely
Make Required Affidavit
Mail or Deliver Report to:
Conservation Division
State Corporation Commission
211 No. Broadway
Wichita, Kansas

Kingman County. Sec. 8 Twp. 30S Rge. (E) 6 (W)
Location as "NE/CNW/SW" or footage from lines C SW SW
Lease Owner Rains & Williamson Oil Co. & Petroleum, Inc.
Lease Name MESSENGER "F" Well No. 1
Office Address 1425 Wichita Plaza, Wichita, Kansas
Character of Well (completed as Oil, Gas or Dry Hole) Dry Hole
Date well completed January 23 19 66
Application for plugging filed January 22 19 66
Application for plugging approved January 22 19 66
Plugging commenced January 22 19 66
Plugging completed January 23 19 66
Reason for abandonment of well or producing formation No oil or gas found in commercial quantities.
If a producing well is abandoned, date of last production - - - 19
Was permission obtained from the Conservation Division or its agents before plugging was commenced? Yes

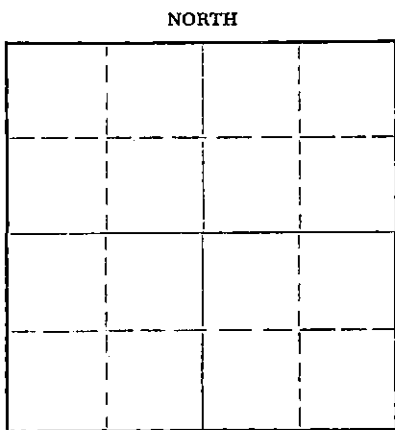

Locate well correctly on above Section Plat

Name of Conservation Agent who supervised plugging of this well Archie Elving, Pratt, Kansas
Producing formation _____ Depth to top _____ Bottom _____ Total Depth of Well 4556 Feet
Show depth and thickness of all water, oil and gas formations.

OIL, GAS OR WATER RECORDS

CASING RECORD

FORMATION	CONTENT	FROM	TO	SIZE	PUT IN	PULLED OUT
				8-5/8"	300'	None

Describe in detail the manner in which the well was plugged, indicating where the mud fluid was placed and the method or methods used in introducing it into the hole. If cement or other plugs were used, state the character of same and depth placed, from _____ feet to _____ feet for each plug set.

Mud to 280', 2 sacks dry cement & 1/3 sack hulls, pushed plug down with drill pipe, added 23 sacks cement, mud to 40', 1 sack dry cement, 1/3 sack hulls, set plug, pushed down with Kelly to form solid bridge, added 9 sacks cement, 2 sacks in rathole. Plug down 2:00 a.m. 1-23-66.

RECEIVED
STATE CORPORATION COMMISSION

JAN 27 1966

CONSERVATION DIVISION
Wichita, Kansas

(If additional description is necessary, use BACK of this sheet)

Name of Plugging Contractor Rains & Williamson Oil Co.
Address 1425 Wichita Plaza, Wichita, Kansas 67202

STATE OF KANSAS, COUNTY OF SEDGWICK, ss.
Wilson Rains ~~owner or operator~~ (owner or operator) of the above-described well, being first duly sworn on oath, says: That I have knowledge of the facts, statements, and matters herein contained and the log of the above-described well as filed and that the same are true and correct. So help me God.

(Signature) Wilson Rains
Wilson Rains
1425 Wichita Plaza, Wichita, Kansas
(Address)

SUBSCRIBED AND SWORN TO before me this 26th day of January, 19 66

My commission expires January 8, 1968

Shirley Keck
Shirley Keck Notary Public.

ROTARY DRILLING LOG

OPERATOR: Rains & Williamson Oil Co. and Petroleum, Inc.
 #1 Messenger "F"
 C SW SW Section 8-30S-6W
 Kingman County, Kansas

CONTRACTOR: Rains & Williamson Oil Co.
 COMMENCED: 1-7-66
 COMPLETED: 1-23-66

REMARKS: Set 300' of 8-5/8" surface casing with 275 sacks cement.

FORMATIONS:

Sand & Gravel	100'
Sand & Shells	515'
Shale & Shells	1080'
Shale & Lime	1535'
Lime & Shale	1700'
Shale & Lime	1900'
Lime & Shale	2090'
Shale & Lime	2831'
Lime & Shale	3130'
Shale & Lime	3276'
Lime & Shale	3500'
Lime	3765'
Lime & Shale	3830'
Lime	4200'
Chert & Lime	4297'
Lime	4357'
Lime & Shale	4556'
Rotary Total Depth (D&A)	4556'

RECEIVED
 STATE CORPORATION COMMISSION

JAN 27 1966

CONSERVATION DIVISION
 Topeka, Kansas

We certify the above log is true and correct to the best of our knowledge and belief.

RAINS & WILLIAMSON OIL CO.

Wilson Rains
 Wilson Rains, Partner

Subscribed and sworn to before me, a Notary Public in and for the State of Kansas, County of Sedgwick, this 26th day of January, 1966.

My Commission Expires:
 January 8, 1968

Shirley Keck
 Shirley Keck, Notary Public