


STATE OF KANSAS
STATE CORPORATION COMMISSION

Form CP-4

Give All Information Completely
Make Required Affidavit
Mail or Deliver Report to:
Conservation Division
State Corporation Commission
212 No. Market
Wichita, Kansas

WELL PLUGGING RECORD

NORTH

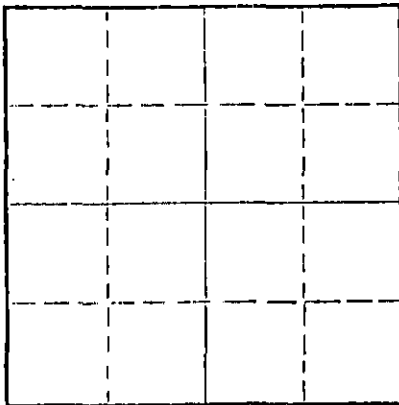

Locate well correctly on above
Section Plat

Kingman County, Sec. 15 Twp. 30 Rge. 6 (E) (W)
Location as "NE/CNWKSW" or footage from lines. C NE SW
Lease Owner Aladdin Petroleum Corporation
Lease Name Dewey Well No. 1
Office Address 809 Petroleum Building Wichita, Kansas
Character of Well (completed as Oil, Gas or Dry Hole)
Date well completed 19
Application for plugging filed 19
Application for plugging approved 19
Plugging commenced 4-10-67 19
Plugging completed 4-15-67 19
Reason for abandonment of well or producing formation

If a producing well is abandoned, date of last production 19
Was permission obtained from the Conservation Division or its agents before plugging was commenced? Yes

Name of Conservation Agent who supervised plugging of this well Archie V. Elving
Producing formation Depth to top Bottom Total Depth of Well 4520 Feet
Show depth and thickness of all water, oil and gas formations.

OIL, GAS OR WATER RECORDS

CASING RECORD

FORMATION	CONTENT	DATE FROM	DATE TO	SIZE	PUT IN	PULLED OUT
				8 5/8	226	None
				4 1/2	None	381.0

Describe in detail the manner in which the well was plugged, indicating where the mud fluid was placed and the method or methods used in introducing it into the hole. If cement or other plugs were used, state the character of same and depth placed, from feet to feet for each plug set.

Moved in. Digging out cellar.

Finished cleaning out cellar. Sanded to 4450'. Dumped 3 sacks of cement. Working pipe. Gas came in - trying to shut it off. Pumping water and mud.

Trying to kill gas. Pumping mud. Shot pipe at 3878'. Picked up bailer. Shut off water.

Mixing and pumping mud. Killed gas. Put on control head. Working pipe. Shot pipe at 3806'. Spotted 75 bbl of oil.

Pulling pipe. Pumped 25 sacks of cement at 700'. Squeezed well with 75 sacks of cement.

Filled hole and capped well with 3 sacks of cement.

(If additional description is necessary, use BACK of this sheet)

Name of Plugging Contractor Forbes Casing Pulling, Inc.
Address P. O. Box 221 Great Bend, Kansas

STATE OF Kansas, COUNTY OF Barton, ss.
J. O. Forbes (employee of owner) or (owner or operator) of the above-described well, being first duly sworn on oath, says: That I have knowledge of the facts, statements, and matters herein contained and the log of the above-described well as filed and that the same are true and correct. So help me God.

(Signature) J. O. Forbes
P. O. Box 221 Great Bend, Kansas
(Address)

SUBSCRIBED AND SWORN TO before me this 20 day of April, 19 67

My commission expires May 27, 1969

Notary Public.