


WELL PLUGGING RECORD

Give All Information Completely  
Make Required Affidavit  
Mail or Deliver Report to:  
Conservation Division  
State Corporation Commission  
800 Bittling Building  
Wichita, Kansas

Kingman County. Sec. 15 Twp. 30 Rge. 6 (E) (W)  
Location as "NE/CNW/SW" or footage from lines NE NE NW  
Lease Owner Trans Era Petroleum, Inc.  
Lease Name Tullgren Well No. 1  
Office Address 420 West Douglas, Wichita, Kansas  
Character of Well (completed as Oil, Gas or Dry Hole) Dry Hole  
Date well completed 7/8/55 19  
Application for plugging filed 7/7/55 19  
Application for plugging approved 7/7/55 19  
Plugging commenced 7/8/55 19  
Plugging completed 7/8/55 19  
Reason for abandonment of well or producing formation Dry Hole

NORTH

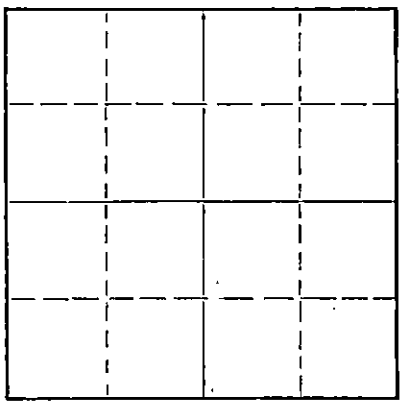

Locate well correctly on above  
Section Flat

If a producing well is abandoned, date of last production \_\_\_\_\_ 19\_\_\_\_  
Was permission obtained from the Conservation Division or its agents before plugging was commenced? yes

Name of Conservation Agent who supervised plugging of this well M. A. Rives  
Producing formation \_\_\_\_\_ Depth to top \_\_\_\_\_ Bottom \_\_\_\_\_ Total Depth of Well 4670 Feet  
Show depth and thickness of all water, oil and gas formations.

OIL, GAS OR WATER RECORDS

CASING RECORD

FORMATION	CONTENT	FROM	TO	SIZE	PUT IN	PULLED OUT
				8 5/8	223	none

Describe in detail the manner in which the well was plugged, indicating where the mud fluid was placed and the method or methods used in introducing it into the hole. If cement or other plugs were used, state the character of same and depth placed, from \_\_\_\_\_ feet to \_\_\_\_\_ feet for each plug set.

PLUGGING RECORD

Layed down drill pipe. Plugged hole. Filled hole with heavy mud to 210' and set first plug, using 20 sacks cement. Filled hole to 35' Set second plug, using 10 sacks cement. Tied top plug

7-20-1955  
CONS. DIV.  
WICHITA, KANSAS

(If additional description is necessary, use BACK of this sheet)  
Name of Plugging Contractor Trans Era Petroleum, Inc.  
Address 420 West Douglas, R Wichita, Kansas

STATE OF KANSAS COUNTY OF RUSSELL, ss.  
R. B. Shindhelm (employee of owner) or (owner or operator) of the above-described well, being first duly sworn on oath, says: That I have knowledge of the facts, statements and matters herein contained and the log of the above-described well as filed and that the same are true and correct. So help me God.

(Signature) R. B. Shindhelm

(Address)

SUBSCRIBED AND SWORN to before me this 19th day of July, 19 55

My commission expires 1-30--57

Maggie Cooper  
Notary Public.

PLUGGING  
FILE SEC 15 T 30 R 6W  
BOOK PAGE 134 LINE 14

Trans Era Petroleum, Inc.  
Tullgren #1

NE NE NW 15-30-6  
Kingman County, Kansas

Total Depth: 4670

Comm: 6/21/55  
Comp: 7/8/55

Casing:  
8 5/8" @ 223

Cement  
175 sacks of Bulk

FORMATION	DEPTH
Surface Soil & Sand	40
Red Rock	180
Red Clay	223
Shale & Shells	260
Shale	540
Shale & Anhy	705
Shale	895
Anhydrite	940
Shale	995
Salt	1025
Anyh. & Shale	1145
Salt	1275
Lime & Shale	1370
Lime	1495
Lime & Shale	3520
Lime	4125
Lime & Chert	4213
Lime	4362
Kinderhook Shale	4395
Shale	4430
Lime & Shale	4498
Shale & Sand	4533
Sand	4575
Sandy Shale	4614
Sand	4634
Arbuckle	4670

RECEIVED  
STATE CORPORATION COMMISSION  
JUL 2 1955  
CONSERVATION DIVISION  
Wichita, Kansas

STATE OF KANSAS )  
COUNTY OF RUSSELL ) ss:

I hereby certify that the above information is true and correct to the best of my knowledge.

*[Signature]*

Subscribed and sworn to before me this 19th day of July, 1955.

*Margie Cooper*  
Notary Public

My commission expires 1-30-57.

PLUGGING  
NE NE NW 15 T 30 R 6W  
BOOK PAGE 134 LINE 14