


Give All Information Completely  
Make Required Affidavit  
Mail or Deliver Report to:  
Conservation Division  
State Corporation Commission  
212 No. Market  
Wichita, Kansas

WELL PLUGGING RECORD

Kingman County, Sec. 14 Twp. 30S Rge. 6 (E) W (W)

Location as "NE/CNW%SW%" or footage from lines C SW  
Lease Owner Walters Drilling Co.  
Lease Name Kostner Well No. 1  
Office Address 400 Insurance Bldg., Wichita, Kansas  
Character of Well (completed as Oil, Gas or Dry Hole) dry hole  
Date well completed 5-12 19 70  
Application for plugging filed 5-12 19 70  
Application for plugging approved 5-12 19 70  
Plugging commenced 5-12 19 70  
Plugging completed 5-12 19 70  
Reason for abandonment of well or producing formation Dry hole

NORTH

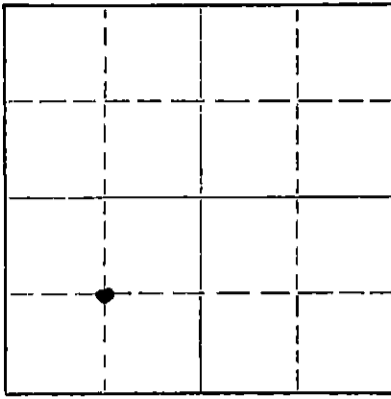

Locate well correctly on above Section Plat

If a producing well is abandoned, date of last production 19  
Was permission obtained from the Conservation Division or its agents before plugging was commenced? Yes

Name of Conservation Agent who supervised plugging of this well Russ Biberstein  
Producing formation Depth to top Bottom Total Depth of Well Feet  
Show depth and thickness of all water, oil and gas formations.

OIL, GAS OR WATER RECORDS

CASING RECORD

FORMATION	CONTENT	FROM	TO	SIZE	PUT IN	PULLED OUT
Surface pipe		0	215	8 5/8"	215	none

Describe in detail the manner in which the well was plugged, indicating where the mud fluid was placed and the method or methods used in introducing it into the hole. If cement or other plugs were used, state the character of same and depth placed, from feet to feet for each plug set.

- Filled hole with heavy mud.
- #1 plug set @ 200' with 25 sks cement.
- #2 plug set @ 40' with 10 sks cement.
- #3 plug in rat hole with 2 sks cement.

RECEIVED  
STATE CORPORATION COMMISSION  
MAY 18 1970  
CONSERVATION DIVISION  
Wichita, Kansas

(If additional description is necessary, use BACK of this sheet)

Name of Plugging Contractor Sweetman Drilling Inc.  
Address Box 645, Great Bend, Kansas

STATE OF Kansas, COUNTY OF Barton, ss.  
T. D. Sweetman (employee of owner) or (owner or operator) of the above-described


well, being first duly sworn on oath, says: That I have knowledge of the facts, statements, and matters herein contained and the log of the above-described well as filed and that the same are true and correct. So help me God.

(Signature) T. D. Sweetman

Box 645, Great Bend, Kansas (Address)

SUBSCRIBED AND SWORN TO before me this 15th day of May, 19 70

Mary Ann Schwamborn Notary Public.

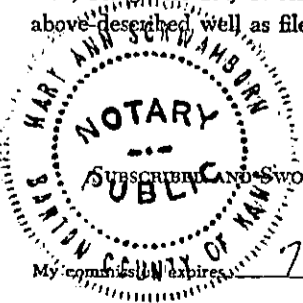

WELL LOG  
Kostner #1  
C SW 14 30S 6W

Name of Operator: Walters Drilling Co.  
400 Insurance Bldg.  
Wichita, Kansas 67200

Date Completed: May 12, 1970

FROM	TO	
0	42	Sand
42	1050	Red bed and shale
1050	3000	Shale and lime
3000		Total depth

RECEIVED  
STATE CORPORATION COMMISSION  
MAY 18 1970  
CONSERVATION DIVISION  
Wichita, Kansas

STATE OF KANSAS

COUNTY OF BARTON ss

T. D. Sweetman, President of Sweetman Drilling, Inc., being first duly sworn on oath says: That I have knowledge of the facts, statements and matters herein contained and the log of the above described well as filed and that the same are true and correct.

T. D. Sweetman  
T. D. Sweetman

Subscribed and sworn before me this 15th day of May, 1970.

Mary Ann Schwaborn  
Notary Public Barton County

My Commission Expires 7-10-73

