


STATE OF KANSAS
STATE CORPORATION COMMISSION

Form CP-4

Give All Information Completely
Make Required Affidavit
Mail or Deliver Report to:
Conservation Division
State Corporation Commission
P. O. Box 17027
Wichita, Kansas 67217
NORTH

WELL PLUGGING RECORD

Sumner County, Sec. 21 Twp. 30 Rge. 3 (E) W (W)
Location as "NE/CNW/SE" or footage from lines SW-NW ~~SW~~ (150' SE of)
Lease Owner Mack Oil Company
Lease Name Good Well No. #3
Office Address P. O. Box 400 ; Duncan, Okla. 73533
Character of Well (completed as Oil, Gas or Dry Hole)
Date well completed 19
Application for plugging filed May 1974
Application for plugging approved May 1974
Plugging commenced May 22 1974
Plugging completed May 29 1974
Reason for abandonment of well or producing formation Depleted

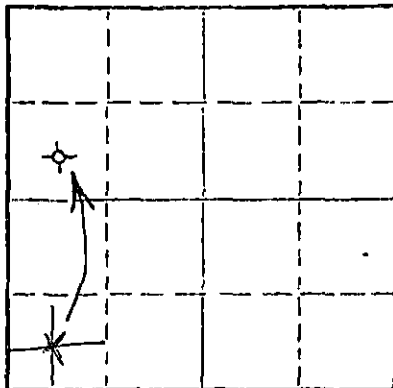

Locate well correctly on above Section Plot

If a producing well is abandoned, date of last production December 1971
Was permission obtained from the Conservation Division or its agents before plugging was commenced? Yes

Name of Conservation Agent who supervised plugging of this well Eugene Graham
Producing formation Simpson Depth to top 4275 Bottom 4276 Total Depth of Well 4276 Feet
Show depth and thickness of all water, oil and gas formations.

OIL, GAS OR WATER RECORDS

CASING RECORD

FORMATION	CONTENT	FROM	TO	SIZE	PUT IN	PULLED OUT
				8 5/8"	250	None
				5 1/2"	4275	2083

Describe in detail the manner in which the well was plugged, indicating where the mud fluid was placed and the method or methods used in introducing it into the hole. If cement or other plugs were used, state the character of same and depth placed, from _____ feet to _____ feet for each plug set.

May 22, 1974 Plugged off bottom. Dumped sand to 3200'. Mixed and dumped 5 sx of cement.
May 29, 1974 Plugged off top. Set 10' rock bridge from 240' to 250'. Mixed and dumped 30 sx of cement. Mudded casing to 40', set 10' rock bridge from 40' to 30'. Mixed and dumped 10 sx of cement from 30' to base of cellar.

RECEIVED
STATE CORPORATION COMMISSION
JUN 13 1974
CONSERVATION DIVISION
Wichita, Kansas

(If additional description is necessary, use BACK of this sheet)
Name of Plugging Contractor RUSS CASING PULLING, INC.
Address P. O. Box 1082 ; Great Bend, Kansas 67530

STATE OF OKLAHOMA, COUNTY OF STEPHENS, ss.
Carl A. Bentley (employee of owner) or (owner or operator) of the above-described

well, being first duly sworn on oath, says: That I have knowledge of the facts, statements, and matters herein contained and the log of the above-described well as filed and that the same are true and correct. So help me God.

(Signature) Carl A. Bentley
P O BOX 400 Duncan Oklahoma 73533
(Address)

SUBSCRIBED AND SWORN TO before me this 12th day of June, 1974.
Josephine Bentley Notary Public.

My commission expires 3-24-75

MACK OIL COMPANY
Duncan, Oklahoma
73533

DRILLERS WELL LOG

#3 Good

150' SE C SW NW - SECTION 21-30S-3W
Sumner County, Kansas.

Commenced R.D. 9-17-71

Elevation: 1347' K.B., 1340' G.L.

Completed R.D. 9-29-71

Initial Production:

Rotary Total Depth: 4275'

Contractor: Thomas Drilling Company

STRATA	DEPTH
Redbed & Shale	0 - 220
Shale	220 - 253
Shale & Anhydrite	253 - 753
Anhydrite	753 - 1110
Shale & Shells	1110 - 1385
Lime & Shale	1385 - 2240
Shale	2240 - 2829
Shale & Lime	2829 - 3140
Lime	3140 - 3738
Lime & Shale	3738 - 3841
Mississippi Chert	3841 - 3853
Lime	3853 - 4195
Shale	4195 - 4272
Sand	4272 - 4275 RTD

I hereby certify that the above is a true and correct log of said well as reflected by the daily drilling reports.

MACK OIL COMPANY

By J. Corry Tinsmon
J. Corry Tinsmon

Signed and sworn to in my presence
this 16th day of November, 1971, by
J. Corry Tinsmon, representative of
Mack Oil Company

Beverly Mann
Beverly Mann, Notary Public

My commission expires:

February 10, 1975

