


STATE OF KANSAS  
STATE CORPORATION COMMISSION

WELL PLUGGING RECORD

Give All Information Completely  
Make Required Affidavit  
Mail or Deliver Report to  
Conservation Division  
State Corporation Comm.  
245 North Water  
Wichita, KS 67202

Summer County. Sec. 21 Twp. 30 Rge. 3 E/W  
Location as "NE/CNW $\frac{1}{4}$ SW $\frac{1}{4}$ " or footage from lines  
150' SW C of NW SE

Lease Owner Ash Oil & Gas  
Lease Name Hartman @-1 Well No. \_\_\_\_\_  
Office Address Wichita, Kansas  
Character of Well (Completed as Oil, Gas or Dry Hole) \_\_\_\_\_

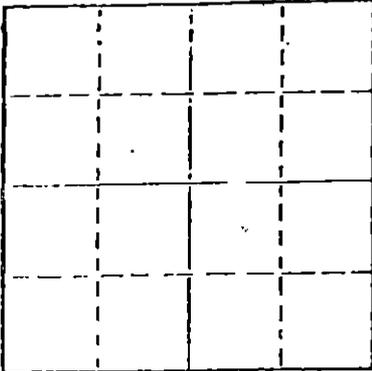

Locate well correctly on above  
Section Plat

Date Well completed \_\_\_\_\_ 19\_\_\_\_  
Application for plugging filed \_\_\_\_\_ 19\_\_\_\_  
Application for plugging approved \_\_\_\_\_ 19\_\_\_\_  
Plugging commenced 1/17/79 \_\_\_\_\_ 19\_\_\_\_  
Plugging completed 1/19/79 \_\_\_\_\_ 19\_\_\_\_  
Reason for abandonment of well or producing formation  
depleted.

If a producing well is abandoned, date of last production \_\_\_\_\_ 19\_\_\_\_

Was permission obtained from the Conservation Division or  
its agents before plugging was commenced? yes

Name of Conservation Agent who supervised plugging of this well Barnett  
Producing formation \_\_\_\_\_ Depth to top \_\_\_\_\_ Bottom \_\_\_\_\_ Total Depth of Well 3418  
Show depth and thickness of all water, oil and gas formations.

OIL, GAS OR WATER RECORDS

CASING RECORD

FORMATION	CONTENT	FROM	TO	SIZE	PUT IN	PULLED OUT
				8-5/8	253	none
				4 1/2"	3414	2716'

Describe in detail the manner in which the well was plugged, indicating where the mud fluid  
was placed and the method or methods used in introducing it into the hold. If cement or other  
plugs were used, state the character of same and depth placed, from \_\_\_\_\_ feet to  
\_\_\_\_\_ feet for each plug set.

Sanded to 3300' and ran 4 sacks cement. Shot pipe at 2990', 2870', 2790', 2710', pulled 67  
joints. Mudded hole to 280', set 10' rock bridge and dumped 40 sacks cement. Mudded hole  
to 40', set 10' rock bridge and dumped 10 sacks cement.

PLUGGING COMPLETE.

(If additional description is necessary, use BACK of this sheet)


Name of Plugging Contractor KELSO CASING PULLING  
CHASE, KANSAS

STATE OF KANSAS COUNTY OF RICE, ss.  
R. DARRELL KELSO (employee of owner) or (owner or operator)  
of the above-described well, being first duly sworn on oath, says: That I have knowledge of  
the facts, statements, and matters herein contained and the log of the above-described well  
as filed and that the same are true and correct. So help me God.

(Signature) [Signature]  
CHASE, KANSAS  
(Address)

SUBSCRIBED AND SWORN TO before me this 23rd day of Jan., 1979

My commission expires \_\_\_\_\_

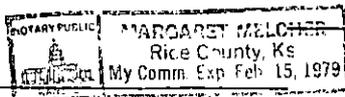

[Signature]  
Notary Public.

RECEIVED  
STATE CORPORATION COMMISSION

JAN 24 1979  
1-24-1979  
CONSERVATION DIVISION  
Wichita, Kansas