


STATE OF KANSAS
STATE CORPORATION COMMISSION

Give All Information Completely
Make Required Affidavit
Mail or Deliver Report to:
Conservation Division
State Corporation Commission
211 No. Broadway
Wichita, Kansas

WELL PLUGGING RECORD

NORTH

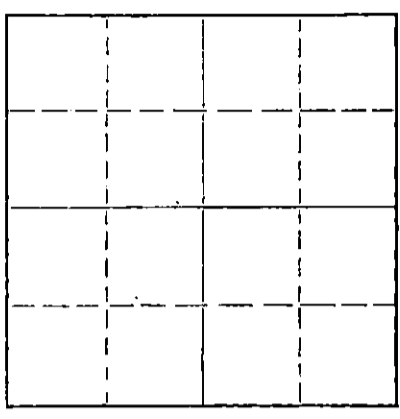

Locate well correctly on above
Section Plat

KINGMAN County, Sec. 16 Twp. 29 Rge. 5 (E) 5 (W)
Location as "NE/CNW%SW%" or footage from lines C NW SE
Lease Owner DRILLERS PRODUCTION CO., INC.
Lease Name SAGER Well No. 1
Office Address UNION NATIONAL BLDG., WICHITA, KANSAS
Character of Well (completed as Oil, Gas or Dry Hole) DRY HOLE
Date well completed 1-5 19 58
Application for plugging filed PHONE 1-5-58 LETTER 4-22 19 63
Application for plugging approved (PHONE) 1-5 19 58
Plugging commenced 1-5 19 58
Plugging completed 1-5 19 58
Reason for abandonment of well or producing formation _____

If a producing well is abandoned, date of last production _____ 19____
Was permission obtained from the Conservation Division or its agents before plugging was commenced? YES

Name of Conservation Agent who supervised plugging of this well FRED HEMPLE
Producing formation _____ Depth to top _____ Bottom _____ Total Depth of Well 4569 Feet
Show depth and thickness of all water, oil and gas formations.

OIL, GAS OR WATER RECORDS

CASING RECORD

FORMATION	CONTENT	FROM	TO	SIZE	PUT IN	PULLED OUT
				8-5/8	255	NONE

Describe in detail the manner in which the well was plugged, indicating where the mud fluid was placed and the method or methods used in introducing it into the hole. If cement or other plugs were used, state the character of same and depth placed, from _____ feet to _____ feet for each plug set.

FILLED HOLE WITH HEAVY MUD TO 250 FEET. SET FIRST PLUG @ 250 FEET WITH 200 SACKS CEMENT. FILLED HOLE WITH HEAVY MUD TO 35 FEET. SET SECOND PLUG @ 35 FEET WITH 10 SACKS CEMENT.

RECEIVED
STATE CORPORATION COMMISSION

APR 23 1963

CONSERVATION DIVISION
Wichita, Kansas

(If additional description is necessary, use BACK of this sheet)

Name of Plugging Contractor GABBERT-JONES DRILLING CO., INC.
Address 514 ORPHEUM BLDG., WICHITA, KANSAS

STATE OF KANSAS, COUNTY OF SEDGWICK, ss.
E. E. HALL (employee of owner) or (owner or operator) of the above-described well, being first duly sworn on oath, says: That I have knowledge of the facts, statements, and matters herein contained and the log of the above-described well as filed and that the same are true and correct. So help me God.

(Signature) E. E. Hall
514 ORPHEUM BLDG., WICHITA, KANSAS
(Address)

SUBSCRIBED AND SWORN TO before me this 22ND day of APRIL, 19 63

My commission expires OCTOBER 2, 1963
Vira A. McKenzie Notary Public.



GABBERT-JONES DRILLING CO., INC.
 WICHITA, KANSAS
 DRILLER'S WELL LOG

SAGER #1
 C NW SE SECTION 16-29S-5W
 KINGMAN COUNTY, KANSAS

COMMENCED: DECEMBER 20, 1957
 COMPLETED: JANUARY 5, 1958

OPERATOR - DRILLERS PRODUCTION CO., INC.

DEPTH		FORMATION	REMARKS
FROM	TO		
0	35	SAND & SHALE	
35	185	SAND, SHALE & SHELLS	
185	256	SHALE & SHELLS	RAN 258.94' OF 8-5/8" CASING, CEMENTED @ 255' W/ 200 SACKS CEMENT
256	725	SHALE	
725	1045	LIME, SHALE & SHELLS	
1045	1400	SHALE & LIME	
1400	1465	SANDY LIME	
1465	1775	LIME & SHALE	
1775	1945	SHALE & SHELLS	
1945	2165	SHALE	
2165	2455	SHALE & SHELLS	
2455	2600	SHALE	
2600	2745	SHALE & SHELLS	
2745	2910	SHALE & LIME	
2910	2940	SHALE	
2940	3200	LIME & SHALE	
3200	3283	SHALE & SAND	
3283	3438	SHALE & LIME	
3438	3454	SHALE & SAND	
3454	2669	LIME	
3669	3899	LIME & SHALE	
3899	3968	SHALE	
3968	4048	LIME & SHALE	
4048	4104	LIME & CHERT	
4104	4343	LIME	
4343	4418	LIME & SHALE	
4418	4434	SHALE	
4434	4478	SAND & SHALE	
4478	4515	SAND	
4515	4566	SHALE & LIME	
4566	4569	LIME	
4569	TD		DRY & ABANDONED

RECEIVED
 STATE CORPORATION COMMISSION
 APR 23 1963
 CONSERVATION DIVISION
 Wichita, Kansas

I, E. E. HALL, CERTIFY THIS TO BE A TRUE AND CORRECT COPY OF THE DRILLERS LOG FOR THE WELL DRILLED IN C NW SE SECTION 16-29S-5W, KINGMAN COUNTY, KANSAS TO THE BEST OF MY KNOWLEDGE AND BELIEF.

E. E. Hall
 E. E. HALL

STATE OF KANSAS)
) SS
 COUNTY OF SEDGWICK)

BEFORE ME, THE UNDERSIGNED, A NOTARY PUBLIC WITHIN AND FOR SAID COUNTY AND STATE, ON THIS 22ND DAY OF APRIL, 1963, PERSONALLY APPEARED E. E. HALL TO ME PERSONALLY KNOWN TO BE THE IDENTICAL PERSON WHO EXECUTED THE WITHIN AND FOREGOING INSTRUMENT AND ACKNOWLEDGED TO ME THAT HE EXECUTED THE SAME AS HIS FREE AND VOLUNTARY ACT AND DEED FOR THE USES AND PURPOSES THEREIN SET FORTH.

IN WITNESS WHEREOF, I HAVE HEREUNTO SET MY HAND AND OFFICIAL SEAL THE DAY AND YEAR LAST ABOVE WRITTEN.

MY COMMISSION EXPIRES OCTOBER 2, 1963

Vira A. McKenzie
 VIRA A. MCKENZIE, NOTARY PUBLIC