

15-095-00184-0000

WELL PLUGGING RECORD

STATE OF KANSAS
STATE CORPORATION COMMISSION

Give All Information Completely
Make Required Affidavit
Mail or Deliver Report to:
Conservation Division
State Corporation Commission
800 Bitting Building
Wichita, Kansas

FORMATION PLUGGING RECORD

Strike out upper line
when reporting plugging
of formations.

Kingman County. Sec. 6 Twp. 29 Rge. (E) 5 (W)

Location as "NE $\frac{1}{4}$ NW $\frac{1}{4}$ SW $\frac{1}{4}$ " or footage from lines. SE SE SE

Lease Owner Earl F. Wakefield

Lease Name Moorehouse Well No. 1

Office Address 307 Union Natl. Bk. Bldg. Wichita, Kansas

Character of Well (completed as Oil, Gas or Dry Hole) Dry Hole

Date well completed July 21 19 51


Application for plugging filed July 23 19 51

Application for plugging approved July 23 19 51

Plugging commenced July 23 19 51

Plugging completed July 23 19 51

Reason for abandonment of well or producing formation

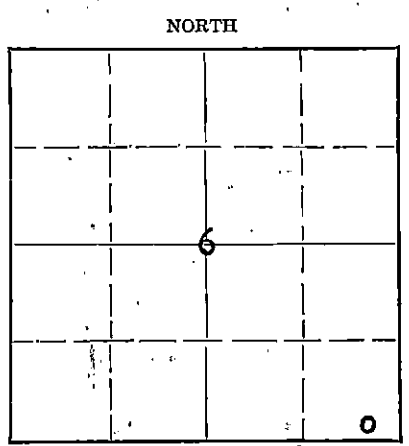

Locate well correctly on above Section Plat

If a producing well is abandoned, date of last production 19

Was permission obtained from the Conservation Division or its agents before plugging was commenced? Yes

Name of Conservation Agent who supervised plugging of this well Ruel Durkee

Producing formation Depth to top Bottom Total Depth of Well 4439 Feet

Show depth and thickness of all water, oil and gas formations.

OIL, GAS OR WATER RECORDS

CASING RECORD

Formation	Content	From	To	Size	Put In	Pulled Out
				8 5/8"	102'	None

Describe in detail the manner in which the well was plugged, indicating where the mud fluid was placed and the method or methods used in introducing it into the hole. If cement or other plugs were used, state the character of same and depth placed, from feet to feet for each plug set.

Heavy drilling mud from 4439' to 110', Cemented with 15 sacks cement heavy mud to 25', 5 sacks cement. Filled with mud to bottom of cellar, welded steel cap on 8 5/8" Surface Pipe

RECEIVED
STATE CORPORATION COMMISSION
JUL 31 1951
CONSERVATION DIVISION
Wichita, Kansas

(If additional description is necessary, use BACK of this sheet)

Correspondence regarding this well should be addressed to Earl F. Wakefield
Address 306 Union National Bank Building
Wichita, Kansas

STATE OF Kansas, COUNTY OF Sedgwick, ss.
Earl F. Wakefield (Employee of owner) or (owner or operator) of the above-described well,
being first duly sworn on oath, says: That I have knowledge of the facts, statements, and matters herein contained and the log of the above-described well as filed and that the same are true and correct. So help me God.

(Signature) Earl F. Wakefield
307 Union Natl. Bk. Bldg., Wichita, Ks.
(Address)

SUBSCRIBED AND SWORN to before me this 30th day of July, 1951

[Signature]
Notary Public.

My commission expires JUL 16 1955

FILED JUL 24 1951
FEE SEC I RTW
BOOK PAGE 96 LINE 45

Moorehouse #1
Owner: Earl F. Wakefield
Contractor: Earl F. Wakefield
Comm: 7-3-51 Comp: 7-22-51

SE SE SE 6-29-5W
Kingman County, Kansas
Casing: 102' of 8 5/8"

Elevation: 1408'

Surface	102
Shale & Shells	1050
Lime & Shale	1495
Shale & Lime	1780
Shale & Shells	1920
Shale & Lime	2148
Shale & Shells	2230
Shale & Lime	2490
Lime & Shale	2651
Sandy Lime & Shale	2687
Lime & Shale	3305
K. C. Lime	3370
Lime	3514
Lime & Shale	3838
Shale & Lime	3900
Mississippi Lime	3937
Lime	4068
Lime & Shale	4230
Lime	4286
Sand & Shale	4340
Lime & Shale	4392
Lime	4439
Total Depth	4439

STATE OF KANSAS)
) SS
COUNTY OF SEEGWICK)

I hereby certify that the above is a true and correct copy of the log on the Moorehouse #1 well located SE SE SE 6-29-5W, Kingman County, Kansas.

RECEIVED
STATE CORPORATION COMMISSION

JUL 31 1951

Earl F. Wakefield
CONSERVATION DIVISION

Wichita, Kansas

Subscribed and sworn to before me this 3rd day of July, 1951

Gladys A. Hruschky

My Commission Expires: JUL 16 1955

PLUGGING
FILE SEC LT 19-5W
BOOK PAGE 26 LINE 45