

WELL PLUGGING RECORD


Give All Information Completely
Make Required Affidavit
Mail or Deliver Report to:
Conservation Division
State Corporation Commission
800 Biting Building
Wichita, Kansas

KINGMAN

County. Sec. 6 Twp. 29 Rge. 5 (E) (W)

Location as "NE/CNW $\frac{1}{4}$ /SW $\frac{1}{4}$ " or footage from lines
Lease Owner MAGNOLIA PETROLEUM COMPANY
Lease Name Oran MOORHOUSE Well No. 1
Office Address Box 770 Great Bend, Kansas
Character of Well (completed as Oil, Gas or Dry Hole) DRY
Date well completed April 11, 1953
Application for plugging filed By Telephone April 13, 1953
Application for plugging approved April 20, 1953 (via phone 4-13-53)
Plugging commenced April 11, 1953
Plugging completed April 11, 1953
Reason for abandonment of well or producing formation Well drilled dry

NORTH

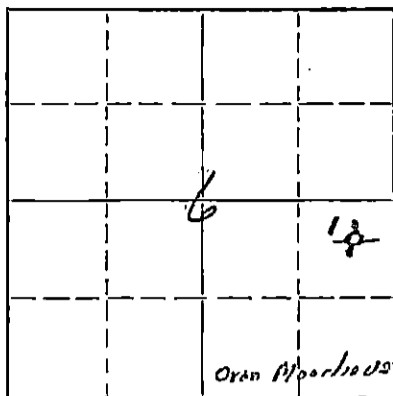

Locate well correctly on above Section Flat

If a producing well is abandoned, date of last production..... 19.....
Was permission obtained from the Conservation Division or its agents before plugging was commenced?..... YES

Name of Conservation Agent who supervised plugging of this well Mr. Ruel Durkee
Producing formation None Depth to top..... Bottom..... Total Depth of Well 4132 Feet
Show depth and thickness of all water, oil and gas formations.

OIL, GAS OR WATER RECORDS

CASING RECORD

Formation	Content	From	To	Size	Put In	Pulled Out
None				13 3/8"	158'	None

Describe in detail the manner in which the well was plugged, indicating where the mud fluid was placed and the method or methods used in introducing it into the hole. If cement or other plugs were used, state the character of same and depth placed, from..... feet to..... feet for each plug set.
Circulated heavy mud from 4132' to 158', plug set @ 158' to 120', ran 20 sx cmnt through drill pipe from 150' to 123', circulated heavy mud from 123' to 7' below base of cellar, spotted 5 sx cmnt 7' below base of cellar to base of cellar.

RECEIVED
STATE CORPORATION COMMISSION
MAY 15 1953 5-15-53
CONSERVATION DIVISION
Wichita, Kansas

Name of Plugging Contractor Barnett Drilling Co.
Address Wichita, Kansas

STATE OF KANSAS, COUNTY OF BARTON, ss.
C. A. Hill, Dist. Supt. (employee of owner) or (owner/operator) of the above-described well, being first duly sworn on oath, says: That I have knowledge of the facts, statements, and matters herein contained and the log of the above-described well as filed and that the same are true and correct. So help me God.

(Signature) [Signature]
Box 770, Great Bend, Kansas
(Address)

SUBSCRIBED AND SWORN to before me this 7th day of May 1953.
Harriett S. Kaiser
Notary Public.

My commission expires 1-11-57

PLUGGING
FILE SEC 6 T 29 R 5W
BOOK PAGE 94 LINE 7

WELL LOG

Oran MOORHOUSE #1 Kingman County Chase District State of Kansas
 330' FNL & 330' FEL of SE/4 Sec. 6-29S-5W

Drilling commenced 3/20/53 Barnett Drilling Company
 Drilling completed 4/12/53 Wichita, Kansas

13 3/8" Armco SJ 158' Cem w/250 sx
 Drilled dry & abandoned

Elevation: 1398.4'

FORMATION:

Sand	0	80
Shale	80	110
Shale & Shells	110	870
Anhydrite	870	905
Shale & Shells	905	1400
Lime & Shale	1400	2540
Lime	2540	2645
Lime & Shale	2645	3195
Lime	3195	3260
Lime & Shale	3260	3365
Lime	3365	3800
Lime & Shale	3800	3915
Lime	3915	3955
Lime & Shale	3955	4005
Lime	4005	4165
Shale	4165	4200
Lime & Shale	4200	4254
Lime	4254	4360
Shale	4360	4380
Lime	4380	4432 TD

Total Depth Drilled: 4432'
 Oil String Set: None
 Plug Back Depth: P & A

Size of Hole: 15" to 158' & 9" from 158' to 4432'

COMPLETION HISTORY:

4/14/53 Plugged by Rotary Tools owned by Barnett Drilling Co, Wichita, Kansas, under the supervision of J. B. Ledbetter, MPCo Production Foreman.

"Circulated heavy mud from 4432' to 158', plug set @ 158' to 120', ran 20 sx cmnt thru drill pipe from 150' to 123', circulated heavy mud from 123' to 7' below base of cellar, spotted 5 sx cmnt 7' below base of cellar to base of cellar.

The only casing left in the hole was the 13 3/8" surface casing which was cemented with 250 sx cmnt circulated.

NEED
 STATE COMMISSION
 MAY 17 1953
 CONSERVATION DIVISION
 Wichita, Kansas

PLUGGING
 FILE SEC 6 T 29R 5W
 BOOK PAGE 94 LINE 2