

15-095-20246-0000


STATE OF KANSAS
STATE CORPORATION COMMISSION

Form CP-4

Give All Information Completely
Make Required Affidavit
Mail or Deliver Report to:
Conservation Division
State Corporation Commission
212 No. Market
Wichita, Kansas 67202

WELL PLUGGING RECORD

NORTH

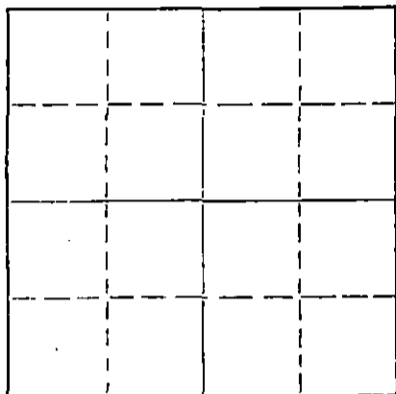

Locate well correctly on above
Section Plat

Kingman County, Sec. 6 Twp. 29S Rge. 5 XXXX (W)
Location as "NE/CNW/SW" or footage from lines C SW SE
Lease Owner Pickrell Drilling Company
Lease Name Moorhouse "A" Well No. 1
Office Address 705 Fourth National Bank Bldg., Wichita, Kansas
Character of Well (completed as Oil, Gas or Dry Hole) Dry Hole
Date well completed June 20 1971
Application for plugging filed June 20 1971
Application for plugging approved June 20 1971
Plugging commenced June 20 1971
Plugging completed June 20 1971
Reason for abandonment of well or producing formation Dry Hole

If a producing well is abandoned, date of last production 19
Was permission obtained from the Conservation Division or its agents before plugging was commenced? Yes

Name of Conservation Agent who supervised plugging of this well Russell Biberstein
Producing formation Depth to top Bottom Total Depth of Well 4335 Feet
Show depth and thickness of all water, oil and gas formations.

OIL, GAS OR WATER RECORDS

CASING RECORD

FORMATION	CONTENT	FROM	TO	SIZE	PUT IN	PULLED OUT
				8 5/8"	212'	None

Describe in detail the manner in which the well was plugged, indicating where the mud fluid was placed and the method or methods used in introducing it into the hole. If cement or other plugs were used, state the character of same and depth placed, from feet to feet for each plug set.

Bottom Plug @ 200' w/35 sacks cement, plug @ 40'
w/10 sacks, plug at rathole w/2 sacks.

RECEIVED
STATE CORPORATION COMMISSION
JUL 2 - 1971
CONSERVATION DIVISION
Wichita, Kansas

(If additional description is necessary, use BACK of this sheet)

Name of Plugging Contractor Pickrell Drilling Company
Address 705 Fourth National Bank Building, Wichita, Kansas 67202

STATE OF Kansas, COUNTY OF Sedgwick, ss.
C. W. Sebitts (employee of owner) or (owner or operator) of the above-described well, being first duly sworn on oath, says: That I have knowledge of the facts, statements, and matters herein contained and the log of the above-described well as filed and that the same are true and correct. So help me God.

(Signature) *C. W. Sebitts*
C. W. Sebitts
705 Fourth National Bank Bldg., Wichita, Kansas
(Address)

SUBSCRIBED AND SWORN TO before me this 29th day of June, 1971

My commission expires May 7, 1973
Marilyn J. Snyder
Marilyn Snyder
Notary Public.

ROTARY DRILLING LOG

COMPANY: Pickrell Drilling Company
705 Fourth National Bank Building
Wichita, Kansas 67202

Rotary Drilling Commenced 6/10/71

Rotary Drilling Completed 6/20/71

LOCATION: Moorhouse "A" No. 1, C SW SE Section 6-29S-5W
Kingman County, Kansas

CONTRACTOR: **PICKRELL DRILLING COMPANY**
Wichita, Kansas

CASING RECORD: Run 8 5/8" surface casing set @ 212' KB. Cemented with
130 sacks cement. Completed 6:45 P.M. Circulated.

No oil string run. D & A, Plugged 3:00 P.M. June 20, 1971.

LOG

(Figures indicate bottom of formation — measurements from top of rotary bushing.)

212	Red Rock		
530	Red Rock & Shale	3360	C.F.S. 4323
1395	Shale & Lime	3402	4329
1610	Lime & Shale	3483	
2220	Shale & Lime	3947	
2445	Lime & Shale	4280	
2745	Shale & Lime	4286	
2900	Lime & Shale	4294	
3179	Shale & Lime	4302	
3260	Lime & Shale	4317	
3370	Lime		
3600	Lime & Shale		
3770	Shale & Lime		
4030	Lime & Shale		S.L.M.
4105	Lime & Shale & Lime		3719.49
4191	Lime & Shale	Strap Board	3718.85
4220	Shale		.64 Difference
4302	Lime & Shale		
4321	Lime		
4329	Simpson Dolomite		Slope Tests
4335	Simpson Sand, RTD		2000
			2500
			3000
			3500
			4000

RECEIVED
STATE CORPORATION COMMISSION
JUL 2 - 1971
CONSERVATION DIVISION
Wichita, Kansas

The undersigned, C. W. Sebitts, Attorney-in-Fact for PICKRELL DRILLING COMPANY, hereby certifies in behalf of said Company, that the above is a true and correct log of the formation encountered in drilling the above well as reflected by the Daily Drilling Reports.

PICKRELL DRILLING COMPANY
By [Signature]
C. W. Sebitts Attorney-in-Fact

STATE OF KANSAS }
COUNTY OF SEDGWICK } ss.:

On this 29th day of June, 19 71, before me the undersigned, a Notary Public, in and for the County and State aforesaid, personally appeared C. W. Sebitts, to me known to be the identical person who subscribed the name of PICKRELL DRILLING COMPANY to the foregoing instrument as its Attorney-in-Fact and acknowledged to me that he executed the same as his free and voluntary act and deed, and as the free and voluntary act and deed of such company, for the uses and purposes therein set forth.

Given under my hand and seal of office the day and year last above written.

My commission expires: May 7, 1973

[Signature]
Marilyn Snyder Notary Public