


STATE OF KANSAS
STATE CORPORATION COMMISSION

WELL PLUGGING RECORD

Give All Information Completely
Make Required Affidavit
Mail or Deliver Report to
Conservation Division
State Corporation Comm.
245 North Water
Wichita, KS 67202

Kingman County, Sec. 6 Twp. 29S Rge. 5 E/W
Location as "NE/CNW $\frac{1}{2}$ SW $\frac{1}{2}$ " or footage from lines
C SW NW

Lease Owner Con-Am, Inc.
Lease Name Kostner Well No. 1
Office Address 600 One Main Place, Wichita, Kansas
Character of Well (Completed as Oil, Gas or Dry Hole) 67202

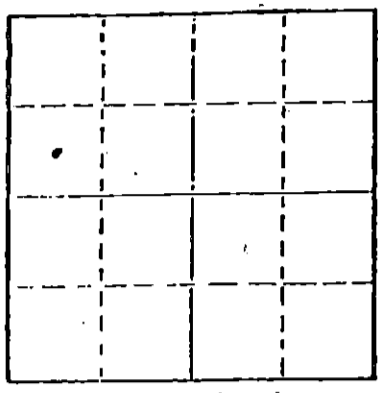

Locate well correctly on above
Section Plat

oil
Date Well completed July 11 1967
Application for plugging filed July 14 1980
Application for plugging approved 19
Plugging commenced July 24 1980
Plugging completed August 11 1980
Reason for abandonment of well or producing formation
depleted

If a producing well is abandoned, date of last production 19

Was permission obtained from the Conservation Division or
its agents before plugging was commenced? yes

Name of Conservation Agent who supervised plugging of this well William T. Owen
Producing formation _____ Depth to top _____ Bottom _____ Total Depth of Well 3960'
Show depth and thickness of all water, oil and gas formations.

OIL, GAS OR WATER RECORDS

CASING RECORD

FORMATION	CONTENT	FROM	TO	SIZE	PUT IN	PULLED OUT
			381'	8 5/8"	381'	none
			3956'	4 1/2"	3956'	3023.58

Describe in detail the manner in which the well was plugged, indicating where the mud fluid
was placed and the method or methods used in introducing it into the hold. If cement or other
plugs were used, state the character of same and depth placed, from _____ feet to
_____ feet for each plug set.

Allied Cementing, Inc. pumped in 35 sacks of cement on bottom. Spot plug
at 3751'.

Allied Cementing, Inc. plugged well pumping in 8 sacks of hulls, 25 sacks
of gel and 125 sacks of cement.

(If additional description is necessary, use BACK of this report)
Name of Plugging Contractor GLENNS CASING PULLING, INC.
Box 413, Ellinwood, Kansas 67526

RECEIVED
STATE CORPORATION COMMISSION
Wichita, Kansas
AUG 20 1980
CONSERVATION DIVISION

STATE OF KANSAS COUNTY OF BARTON
Evelyn Roth (employee of owner) or (owner or operator)

of the above-described well, being first duly sworn on oath, says: That I have knowledge of
the facts, statements, and matters herein contained and the log of the above-described well
as filed and that the same are true and correct. So help me God.

(Signature) Evelyn Roth
Ellinwood, Kansas
(Address)

SUBSCRIBED AND SWORN TO before me this 18th day of August, 1980

JENNY KASSELMAN
STATE NOTARY PUBLIC
Barton County, Kansas
My Appt. Exp. July 16, 1982

Jenny Kasselmann
Notary Public.

My commission expires

Agent Report received

15-095-20871-0000

Operator Con-Am, Inc. & APC DESIGNATE TYPE OF COMP.: OIL, GAS, DRY HOLE, SWDW, ETC.: oil

Well No. 1 Lease Name Kostner

S6 T 29SR 5W E Kingman, County, Kansas

C SW NW WELL LOG SHOW GEOLOGICAL MARKERS, LOGS RUN, OR OTHER DESCRIPTIVE INFORMATION.
 Show all important zones of porosity and contents thereof; cored intervals, and all drill-stem tests, including depth interval tested, cushion used, time tool open, flowing and shut-in pressures, and recoveries.

FORMATION DESCRIPTION, CONTENTS, ETC.	TOP	BOTTOM	NAME	DEPTH
Shale & Sand	0	250		
Shale & gypsum	250	380		
Sand & Shale	380	1040		
Lime	1040	1306		
Shale & lime	1306	1526		
Lime & cherty lime	1526	1756		
Sand & silty sand	1756	1786		
Lime	1786	2500		
Lime & Shale	2500	2852		
Shale, black	2852	2861		
Shale & sandy shale	2861	3208		
Sand, porous	3208	3256		
Sand and sandy shale	3256	3396		
Lime	3396	3521		
Shale, black	3521	3528		
Lime, hard & dense	3528	3800		
Shale, lime	3800	3960		
RTD				

*Perforation
3891-3895'*

RECEIVED
 STATE CORPORATION COMMISSION
 JUL 15 1980
 CONSERVATION DIVISION
 Wichita, Kansas

USE ADDITIONAL SHEETS, IF NECESSARY, TO COMPLETE WELL RECORD.

Date Received	<i>[Signature]</i>
	General Manager
	July 11, 1980

KANSAS DRILLERS LOG

S. 6 T. 29S R. 5W E W

API No. 15 County _____ Number _____

Loc. C SW NW

County Kingman

Operator Con-Am, Inc. & APC

Address One Main Place, Suite 600


Well No. 1 Lease Name Kostner

Footage Location 1980 feet from (N) (S) line 330 feet from (E) (W) line

Principal Contractor Brandt Drilling Co., Inc. Geologist Charles King

Spud Date 8-10-79 Total Depth 3956 P.B.T.D. _____

Date Completed _____ Oil Purchaser _____

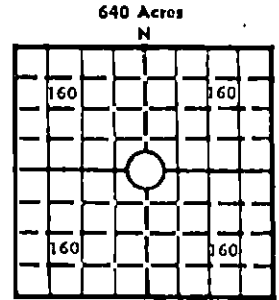

Locate well correctly
Elev.: Gr. 1405

DF 1407 KB 1410

CASING RECORD

Report of all strings set — surface, intermediate, production, etc.

Purpose of string	Size hole drilled	Size casing set (in O.D.)	Weight lbs/ft.	Setting depth	Type cement	Sacks	Type and percent additives
Surface	12 1/4"	8 5/8	24#	381	Common	350	2% Gel 3% CaCl
Production	7 7/8	4 1/2 - 5 1/2		3960			

LINER RECORD

PERFORATION RECORD

Top, ft.	Bottom, ft.	Sacks cement	Shots per ft.	Size & type	Depth interval

TUBING RECORD

Size	Setting depth	Packer set at

ACID, FRACTURE, SHOT, CEMENT SQUEEZE RECORD

Amount and kind of material used	Depth interval treated

RECEIVED
STATE CORPORATION COMMISSION

JUL 15 1980

INITIAL PRODUCTION

CONSERVATION DIVISION
Wichita, Kansas

Date of first production _____ Producing method (flowing, pumping, gas lift, etc.) _____

RATE OF PRODUCTION PER 24 HOURS
Oil _____ bbls. Gas _____ MCF Water _____ bbls. Gas-oil ratio _____ CFPB

Disposition of gas (vented, used on lease or sold) _____ Producing interval (s) _____

INSTRUCTIONS: As provided in KCC Rule 82-2-125, within 90 days after completion of a well, one completed copy of this Drillers Log shall be transmitted to the State Geological Survey of Kansas, 4150 Monroe Street, Wichita, Kansas 67209. Copies of this form are available from the Conservation Division, State Corporation Commission, 3830 So. Meridian (P.O. Box 17027), Wichita, Kansas 66217. Phone AC 316-522-2206. If confidential custody is desired, please note Rule 82-2-125. Drillers Logs will be on open file in the Oil and Gas Division, State Geological Survey of Kansas, Lawrence, Kansas 66044.