


STATE OF KANSAS
STATE CORPORATION COMMISSION

WELL PLUGGING RECORD

Give All Information Completely
Make Required Affidavit
Mail or Deliver Report to:
Conservation Division
State Corporation Commission
211 No. Broadway
Wichita, Kansas

NORTH

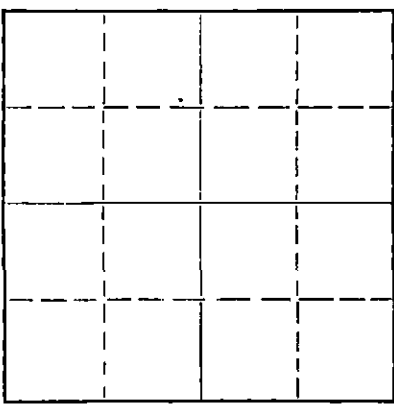

Locate well correctly on above
Section Plat

Kingman County. Sec. 3 Twp. 29S Rge. 5W (E) (W)
Location as "NE/CNW/SW" or footage from lines SE¹ SE¹ SW¹
Lease Owner Aurora Gasoline Company
Lease Name Bolinger Well No. 1
Office Address 802 Union Nat'l Bank Bldg., Wichita, Kansas
Character of Well (completed as Oil, Gas or Dry Hole) Dry Hole
Date well completed 10/3 19 56
Application for plugging filed 10/3 19 56
Application for plugging approved 10/3 19 56
Plugging commenced 10/3 19 56
Plugging completed 10/3 19 56
Reason for abandonment of well or producing formation No Production

If a producing well is abandoned, date of last production 19
Was permission obtained from the Conservation Division or its agents before plugging was commenced? Yes

Name of Conservation Agent who supervised plugging of this well M. A. Rizes
Producing formation Depth to top Bottom Total Depth of Well 4500 Feet
Show depth and thickness of all water, oil and gas formations.

OIL, GAS OR WATER RECORDS

CASING RECORD

FORMATION	CONTENT	FROM	TO	SIZE	PUT IN	PULLED OUT
Soil and Sand	Fresh Water	39'	45'	8 5/8"	179'	None

Describe in detail the manner in which the well was plugged, indicating where the mud fluid was placed and the method or methods used in introducing it into the hole. If cement or other plugs were used, state the character of same and depth placed, from feet to feet for each plug set.

Mud from 4500' to 179'
Halliburton Plug with 15 sacks cement
Mud to 20'
Halliburton Plug with ten sacks cement
Cement to top
Steel plate welded to top.

(If additional description is necessary, use BACK of this sheet)

Name of Plugging Contractor Criswell Drilling Company
Address First National Bank Building, Winfield, Kansas

STATE OF Kansas, COUNTY OF Cowley ss.
John Christensen (employee of owner) or (owner or operator) of the above-described well, being first duly sworn on oath, says: That I have knowledge of the facts, statements, and matters herein contained and the log of the above-described well as filed and that the same are true and correct. So help me God.

(Signature) John Christensen
Box 916, Winfield, Kansas
(Address)

SUBSCRIBED AND SWORN to before me this 15 day of October, 19 56

My commission expires August 20, 1959

Donald W. Dutrick
Notary Public.

PLUGGING
FILE SEC 3 T. 29 R. 5W
BOOK PAGE 104 LINE 23

RECEIVED
STATE CORPORATION COMMISSION
OCT 16 1956
10-16-56
CONSERVATION DIVISION
Wichita, Kansas

WELL LOG

Company: Aurora Gasoline Company
 Farm: Bolinger # 1
 Total Depth: 4500'
 Comm. 9/17/56 Comp. 10/3/56
 Shot or Treated:
 Contractor: Criswell Drilling Company
 Issued:
 Casing: 8 5/8"

Sec. 3, Twp. 29S, Rge. 5W
 Loc. SE $\frac{1}{4}$ SE $\frac{1}{4}$ SW $\frac{1}{4}$
 Kingman County, Kansas.

FIGURES INDICATE BOTTOM OF FORMATIONS

800 - Shale	3674 - Shale and Lime
870 - Shale and Lime Streaks	3742 - Lime and Shale Streaks
925 - Lime	3795 - Shale and Lime
940 - Shale and Sand	3852 - Shale W/Lime
1055 - Lime	3920 - Shale W/Lime
1225 - Shale and Lime	3938 - Shale
1395 - Shale and Lime	3958 - Mississippi Lime
1520 - Lime and Shale	4033 - Mississippi Lime
1690 - Lime and Shale	4072 - Shale
1860 - Shale and Lime	4092 - Lime
2055 - Shale and Lime	4110 - Lime
2185 - Shale	4130 - Shale
2320 - Shale	4153 - Shale
2423 - Shale and Lime Streaks	4204 - Shale and Lime Streaks
2552 - Lime W/Shale	4246 - Shale and Lime
2669 - Lime	4295 - Shale
2790 - Shale and Lime Streaks	4325 - Shale
2955 - Shale and Lime	4340 - Shale
3080 - Shale and Lime	4368 - Sand
3145 - Shale and Lime	4390 - Sand
3159 - Lime	4414 - Shale
3269 - Lime and Shale	4445 - Sandy Shale
3327 - Shale	4475 - Shale
3375 - Lime and Shale Streaks	4487 - Lime-Arbuckle
3427 - Lime	4500 - Lime
3493 - Lime	
3562 - Lime	
3600 - Lime	
3614 - Shale and Lime	

All Measurements K. B.

I, John Christensen, of the Criswell Drilling Company, certify the above rotary log to be true and correct.

CRISWELL DRILLING COMPANY

John Christensen
 John Christensen, Owner

RECEIVED
 STATE CORPORATION COMMISSION
 OCT 16 1956
 CONSERVATION DIVISION
 Wichita, Kansas

PLUGGING
 FILE SEC 3 T 29 R 5W
 BOOK PAGE 104 LINE 23