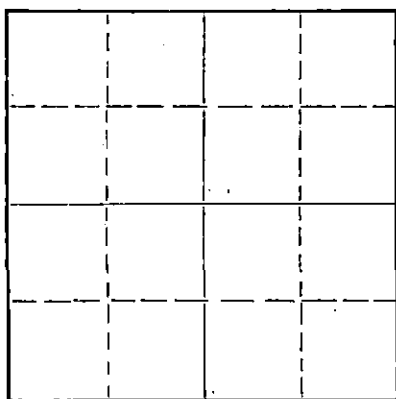


STATE OF KANSAS  
STATE CORPORATION COMMISSIONGive All Information Completely  
Make Required AffidavitMail or Deliver Report to:  
Conservation Division  
State Corporation Commission  
800 Bitting Building  
Wichita, Kansas

## WELL PLUGGING RECORD

NORTH

Locate well correctly on above  
Section Plat

Sedgwick County, Sec. 33 Twp. 29S Rge. 4W (E) (W)

Location as "NE/CNW/SW" or footage from lines NW NE NE

Lease Owner The Texas Company

Lease Name Mary Casner

Well No. 1

Office Address 614 Bitting Building, Wichita, Kansas

Character of Well (completed as Oil, Gas or Dry Hole) Dry Hole

Date well completed May 5 19 54

Application for plugging filed May 5 19 54

Application for plugging approved (Verbal 5-4) May 5 19 54

Plugging commenced May 5 19 54

Plugging completed May 6 19 54

Reason for abandonment of well or producing formation

If a producing well is abandoned, date of last production 19

Was permission obtained from the Conservation Division or its agents before plugging was commenced? Yes

Name of Conservation Agent who supervised plugging of this well Mr. Ruel Durkee

Producing formation Depth to top Bottom Total Depth of Well 4383 Feet

Show depth and thickness of all water, oil and gas formations.

## OIL, GAS OR WATER RECORDS

## CASING RECORD

| FORMATION | CONTENT | FROM | TO | SIZE    | PUT IN | PULLED OUT |
|-----------|---------|------|----|---------|--------|------------|
|           |         |      |    | 10-3/4" | 511'   | 0'         |
|           |         |      |    |         |        |            |
|           |         |      |    |         |        |            |
Describe in detail the manner in which the well was plugged, indicating where the mud fluid was placed and the method or methods used in introducing it into the hole. If cement or other plugs were used, state the character of same and depth placed, from feet to feet for each plug set.

## PLUGGED AS FOLLOWS:

4383' to 250' - Heavy Mud

250' to 184' - 22 Sacks Cement

184' to 30' - Heavy Mud

30' to Bottom of Celler - 12 Sacks Cement

(If additional description is necessary, use BACK of this sheet)

Name of Plugging Contractor Stickle Drilling Company

Address Box 117, Great Bend, Kansas

STATE OF Kansas, COUNTY OF Sedgwick, ss.

M. C. Harrell

(employee of owner) or (owner or operator) of the above-described well, being first duly sworn on oath, says: That I have knowledge of the facts, statements, and matters herein contained and the log of the above-described well as filed and that the same are true and correct. So help me God.

(Signature)

614 Bitting Building, Wichita, Kansas

(Address)

SUBSCRIBED AND SWORN TO before me this 7th day of May, 19 54

My commission expires September 20, 1956

Notary Public.

PLUGGING

FILE SEC 33 T 29 R 4W  
BOOK PAGE 32 LINE 14FILED  
STATE CORPORATION COMMISSION

MAY 20 1954 5-20-54

CONSERVATION DIVISION  
Wichita, Kansas

The Texas Company  
Tulsa, Oklahoma

Tulsa, Oklahoma  
May 7, 1954

CONTRACTOR: Stickle Drilling Company  
Drilling Commenced: April 16, 1954  
Drilling Completed: May 5, 1954

Mary Casner #1 NW-NE-NE-  
Section 33-29S-4W,  
Sedgwick County, Kansas.

# DRILLERS LOG

|                        |              |
|------------------------|--------------|
| Red Bed                | 5-205        |
| Red Bed Shale & Shells | 205-511      |
| Red Bed & Sand         | 511-645      |
| Shale Salt & Shells    | 645-890      |
| Anhydrite              | 890-923      |
| Shale & Lime           | 923-1230     |
| Lime & Shale           | 1230-1805    |
| Shale                  | 1805-1962    |
| Shale & Lime           | 1962-2360    |
| Lime                   | 2360-2468    |
| Lime & Shale           | 2468-2672    |
| Broken Lime            | 2672-2744    |
| Chalky Lime & Shale    | 2744-2835    |
| Lime & Shale           | 2835-2915    |
| Shale & Sand           | 2915-3040    |
| Sand                   | 3040-3155    |
| Sand & Shale           | 3155-3255    |
| Shale & Lime           | 3255-3340    |
| Lime & Shale           | 3340-3405    |
| Lime                   | 3405-3553    |
| Lime & Shale           | 3553-3913    |
| Shale & Shells         | 3913-3935    |
| Chat & Lime            | 3935-3957    |
| Lime                   | 3957-4050    |
| Lime Broken & Cherty   | 4050-4135    |
| Lime                   | 4135-4233    |
| Lime & Shale           | 4233-4368    |
| Sand                   | 4368-4383 TD |


I, LaVerne Raper hereby certify the above to be a true and complete Drillers Log of The Texas Company's Mary Casner #1 NW-NE-NE-Section 33-29S-4W, Sedgwick County, Kansas.

La Verne Raper  
LaVerne Raper

Lillian T. Bonham  
Notary Public

My Commission Expires

Feb. 13, 1956

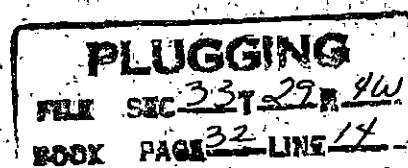

state

# LOG OF WELL

FORM PO-214 Sheet 1 (11-53) 25M

MARY CASNER NO. 1

SHEET

OWNER The Texas Company DIVISION Oklahoma DATE MADE May 18, 1954  
DISTRICT Kansas LEASE Mary Casner WELL NO. 1  
STATE Kansas COUNTY OR PARISH Sedwick TWP. 29S RANGE 4W SEC. 33  
LOCATION OF WELL NW NE NE

COMMENCED RIGGING UP 4-16-54 COMMENCED DRILLING 4-17-54 COMPLETED DRILLING 5-5-54  
DAY DRILLER \_\_\_\_\_ NIGHT DRILLER \_\_\_\_\_ CONTRACTOR Stickle Drlg. Co.  
CABLE FROM \_\_\_\_\_ TO \_\_\_\_\_ ROTARY FROM 0' TO 4383' COMPANY RIG NO. \_\_\_\_\_  
TOTAL DEPTH 4383' MEASURED BY M. C. Harrell ELEVATION KB - 1383

## CASING RECORD

| SIZE    | WEIGHT | PUT IN WELL        |      | PULLED OUT             |      | LOST IN WELL       |      | SHOES              |      | PACKERS |        |        |
|---------|--------|--------------------|------|------------------------|------|--------------------|------|--------------------|------|---------|--------|--------|
|         |        | FEET               | INS. | FEET                   | INS. | FEET               | INS. | LENGTH             | MAKE | KIND    | LENGTH | SET AT |
| 10-3/4" | 32.75# | 511'               |      |                        |      | (H-40, new casing) |      |                    |      |         |        |        |
|         |        |                    |      |                        |      |                    |      |                    |      |         |        | FT.    |
| 10-3/4" |        | casing set at 511' |      | with 525 sacks cement. |      | 5 sacks CC.        |      | Cement circulated. |      |         |        |        |

WAS CASING CEMENTED? \_\_\_\_\_ IF SO, HOW MANY SACKS OF CEMENT USED? \_\_\_\_\_  
 LINER: STATE SIZE AND WEIGHT \_\_\_\_\_ WHERE SET \_\_\_\_\_ FT. AND INS. \_\_\_\_\_  
 BLANK \_\_\_\_\_ FT. AND INS. \_\_\_\_\_  
 PERFORATED \_\_\_\_\_  
 HOW PUT TOGETHER \_\_\_\_\_ COUPLING \_\_\_\_\_ FLUSH JOINT \_\_\_\_\_ INSERTED \_\_\_\_\_  
 REMARKS: \_\_\_\_\_

## EQUIPMENT RECORD

| TUBING             |        |        |      | SUCKER RODS |      |               | PUMPING OUTFIT                |
|--------------------|--------|--------|------|-------------|------|---------------|-------------------------------|
| SIZE               | WEIGHT | FEET   | INS. | FEET        | INS. | SIZE AND KIND | DESCRIPTION, KIND, SIZE, ETC. |
|                    |        |        |      |             |      |               |                               |
|                    |        |        |      |             |      |               |                               |
| Completed Plugging |        | 5-6-51 |      |             |      |               |                               |

FLOWING, PUMPING, GASSEY OR DRY \_\_\_\_\_ PRODUCTION FIRST 24 HOURS \_\_\_\_\_ PRODUCTION SETTLED \_\_\_\_\_

IF GAS WELL, OPEN FLOW CAPACITY \_\_\_\_\_ SHUT IN PRESSURE \_\_\_\_\_ ROCK PRESSURE \_\_\_\_\_

KIND OF SHOT \_\_\_\_\_ SIZE OF SHOT, QUARTS \_\_\_\_\_

NUMBER OF SHELLS \_\_\_\_\_ SIZE OF SHELLS \_\_\_\_\_ INCHES, DIAMETER \_\_\_\_\_

LENGTH OF SHELLS \_\_\_\_\_ FEET \_\_\_\_\_ INCHES \_\_\_\_\_ TOP OF SHOT \_\_\_\_\_

BOTTOM OF SHOT \_\_\_\_\_ ANCHOR \_\_\_\_\_ WELL BRIDGED TO \_\_\_\_\_

TOTAL DEPTH OF WELL \_\_\_\_\_ NUMBER OF SHOT \_\_\_\_\_ PRODUCTION BEFORE SHOT \_\_\_\_\_ BBLs. PER DAY \_\_\_\_\_

PRODUCTION AFTER SHOT \_\_\_\_\_ BBLs. PER DAY. SHOT FURNISHED BY \_\_\_\_\_

NAME OF SHOOTER \_\_\_\_\_ SHOT INSPECTED \_\_\_\_\_ BY \_\_\_\_\_  
(COMPANY EMPLOYEE)

COMMENCED DRILLING DEEPER \_\_\_\_\_ COMPLETED \_\_\_\_\_ DRILLING DEEPER \_\_\_\_\_

TOTAL DEPTH \_\_\_\_\_ PRODUCTION FIRST 24 HOURS \_\_\_\_\_ PRODUCTION SETTLED \_\_\_\_\_

REMARKS:

STATE CORPORATION  
MAKAPUOUE POINT  
COMPLETION

Mary Casner #1  
Wildcat  
TD 4383'  
Completed Drilling 5-5-54  
Completed Plugging 5-6-54

NOTE: IF WELL WAS DRY, STATE UNDER REMARKS WHEN, HOW, AND BY WHOM PLUGGED.  
STATE UNDER REMARKS ANYTHING OF INTEREST NOT COVERED IN LOG.  
IF THE SPACE PROVIDED FOR REMARKS IS NOT SUFFICIENT WRITE ON BOTTOM OF LAST SHEET OF LOG.

TOTAL NUMBER OF SHEETS

## LOG OF WELL

SHEET No. 2

District Kansas

Owner The Texas Company Farm Mary Casner

Well No. 1

| FORMATION               | AMOUNT   | COLOR | HARD OR SOFT | DEPTH CORES TAKEN | REMARKS |
|-------------------------|---|-------|--------------|-------------------|---------|
| <u>REMARKS:</u>         |   |       |              |                   |         |
| 4-27-54                 | Ran DST #1 from 3472-85', open 1 hour, recovered 185' salt water, initial flow pressure 14#, final flow pressure 82#, SBHP 1486# in 30 minutes.                |       |              |                   |         |
| 5-3-54                  | Took Core #1 from 4343-57-1/2', recovered 14-1/2'. Took Core #2 from 4357-1/2-63', recovered 5'3".                                                             |       |              |                   |         |
| 5-4-54                  | Ran DST #2 from 4340-63', open 2 hours, recovered 70' drilling mud and 30' watery mud. SBHP 255# in 30 minutes. Took Core #3 from 4363-68', recovered 5' sand. |       |              |                   |         |
| 5-5-54                  | Ran DST #3 from 4357-63', open 1 hour, recovered 1080' muddy salt water. SBHP 1528# in 30 minutes. Drilled to 4383' in sand. Well dry.                         |       |              |                   |         |
| <u>TOPS:</u>            |   |       |              |                   |         |
| Severy Sand-----2305'   |   |       |              |                   |         |
| Topeka-----2353'        |   |       |              |                   |         |
| Heebner-----2730'       |   |       |              |                   |         |
| Stalnaker-----3070'     |   |       |              |                   |         |
| Lansing-----3145'       |   |       |              |                   |         |
| Kansas City-----3310'   |   |       |              |                   |         |
| Basic Kansas City-3523' |   |       |              |                   |         |
| Marmaton-----3602'      |   |       |              |                   |         |
| Cherokee-----3738'      |   |       |              |                   |         |
| Mississippi-----3935'   |   |       |              |                   |         |
| Kinderhook-----4260'    |   |       |              |                   |         |
| Chattanooga-----4339'   |   |       |              |                   |         |
| Simpson-----4356'       |   |       |              |                   |         |