

Q


STATE OF KANSAS  
STATE CORPORATION COMMISSION

Form CP-4

Give All Information Completely  
Make Required Affidavit  
Mail or Deliver Report to:  
Conservation Division  
State Corporation Commission  
212 No. Market  
Wichita, Kansas

WELL PLUGGING RECORD

NORTH

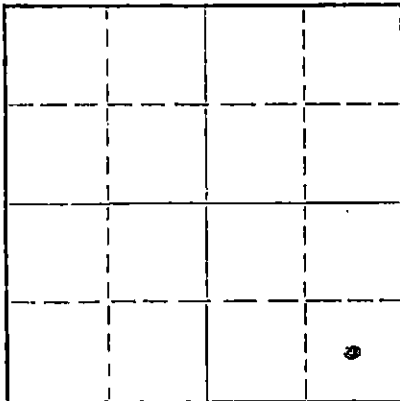

Locate well correctly on above  
Section Plat

Sedgwick County. Sec. 36 Twp. 29S Rge. - (E) 4 (W)  
Location as "NE/CNW/SW" or footage from lines Center of SE-SE  
Lease Owner Shenandoah Oil Corporation  
Lease Name John Richard Small Well No. 1  
Office Address 406 Mutual Savings Bldg., Fort Worth, Texas  
Character of Well (completed as Oil, Gas or Dry Hole) Dry Hole  
Date well completed June 21 19 67  
Application for plugging filed June 21 19 67  
Application for plugging approved June 21 19 67  
Plugging commenced June 21 19 67  
Plugging completed 6:30 P.M. June 21 19 67  
Reason for abandonment of well or producing formation No commercial shows  
of oil or gas.  
If a producing well is abandoned, date of last production - 19 -  
Was permission obtained from the Conservation Division or its agents before plugging was commenced? Yes

Name of Conservation Agent who supervised plugging of this well Mr. Herman Justus, Box 71, Nickerson, Kansas  
Producing formation - Depth to top - Bottom - Total Depth of Well 4407 Feet  
Show depth and thickness of all water, oil and gas formations.

OIL, GAS OR WATER RECORDS

CASING RECORD

| FORMATION    | CONTENT | FROM  | TO    | SIZE   | PUT IN | PULLED OUT |
|--------------|---------|-------|-------|--------|--------|------------|
| Mississippi  | Water   | 3952' | 4298' | 8-5/8" | 278'   | None       |
| Simpson Sand | Water   | 4390' | 4407' |        |        |            |
|              |         |       |       |        |        |            |
|              |         |       |       |        |        |            |
Describe in detail the manner in which the well was plugged, indicating where the mud fluid was placed and the method or methods used in introducing it into the hole. If cement or other plugs were used, state the character of same and depth placed, from - feet to - feet for each plug set.

Hole filled with heavy mud. Spotted 25 sack cement plug at 250 feet, 10 sack cement plug at 40 feet and 2 sacks cement in rat hole.

RECEIVED  
STATE CORPORATION COMMISSION  
JUN 26 1967  
CONSERVATION DIVISION  
WICHITA, KANSAS

(If additional description is necessary, use BACK of this sheet)

Name of Plugging Contractor S & S Drilling Company  
Address Great Bend, Kansas

STATE OF Texas, COUNTY OF Tarrant, ss.  
Harold E. Burke (employee of owner) or (owner or operator) of the above-described well, being first duly sworn on oath, says: That I have knowledge of the facts, statements, and matters herein contained and the log of the above-described well as filed and that the same are true and correct. So help me God.

(Signature)

Harold E. Burke  
406 Mutual Savings Bldg, Fort Worth, Texa  
(Address)

Subscribed and Sworn to before me this 22nd day of June, 1967

My commission expires

June 1, 1969

Dora Benson

Notary Public.

GP

DRILLER'S LOG

Company: Shenandoah Oil Corporation  
 Contractor: S & S Drilling Company  
 Lease: John Richard Small Well No. 1  
 Location: Center of SE-SE  
 Section 36, T29S, R4W  
 Sedgwick County, Kansas  
 Commenced: June 8, 1967  
 Completed: June 21, 1967

|      |      |                 |
|------|------|-----------------|
| 0    | 278  | Red Bed & shale |
| 278  | 800  | Shale & red bed |
| 800  | 1235 | Shale & lime    |
| 1235 | 1525 | Shale & lime    |
| 1525 | 1930 | Shale & lime    |
| 1930 | 2695 | Lime & shale    |
| 2695 | 3060 | Lime & shale    |
| 3060 | 3348 | Shale & lime    |
| 3348 | 3488 | Lime            |
| 3488 | 3688 | Lime            |
| 3688 | 3764 | Shale & lime    |
| 3764 | 3875 | Lime            |
| 3875 | 4241 | Lime            |
| 4214 | 4336 | Lime            |
| 4336 | 4392 | Shale           |
| 4392 | 4407 | Sand            |
| 4407 |      | Total Depth     |

RECEIVED  
 STATE CORPORATION COMMISSION  
 JUN 26 1967  
 CONSERVATION DIVISION  
 Wichita, Kansas

8-5/8" 20# new surface casing set at 278 feet with 175 sacks regular cement with HA-5.

I, Harold E. Burke, do hereby certify that the above and foregoing is a true and correct copy of the log of the John Richard Small Well No. 1, located in Center of SE-SE of Section 36, T29S, R4W, Sedgwick County, Kansas, as reflected by the records of S & S Drilling Company.

Harold E. Burke

State of Kansas

SS

County of Tarrant

Subscribed and sworn to and before me, a Notary Public for Tarrant County, Texas, this 22nd day of June, 1967.

Grover Benson

My Commission Expires:

June 1, 1969