


STATE OF KANSAS
STATE CORPORATION COMMISSION

WELL PLUGGING RECORD

Give All Information Completely
Make Required Affidavit
Mail or Deliver Report to
Conservation Division
State Corporation Comm.
245 North Water
Wichita, KS 67202

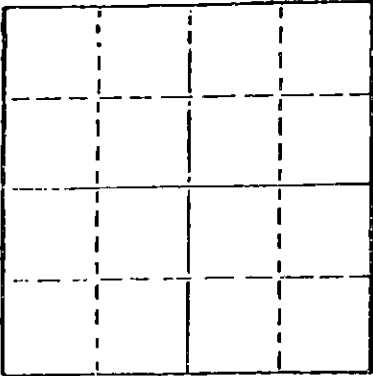

Locate well correctly on above
Section Plat

Sedgwick County. Sec. 22 Twp. 29s Rge. 4 NE/W
Location as "NE/CNW¹/SW¹" or footage from lines
NW NW SE
Lease Owner Derrick-American Oil, Inc.
Lease Name Koster Well No. 1
Office Address 507 Insurance Building, Wichita, KS 67202
Character of Well (Completed as Oil, Gas or Dry Hole) Dry Hole
Date Well completed 12-1 1978
Application for plugging filed 12-1 1978
Application for plugging approved 12-1 1978
Plugging commenced 12-1 1978
Plugging completed 12-1 1978
Reason for abandonment of well or producing formation
No commercial quantities of oil or gas encountered
If a producing well is abandoned, date of last production 19

Was permission obtained from the Conservation Division or
its agents before plugging was commenced? Yes

Name of Conservation Agent who supervised plugging of this well Don Thomason
Producing formation _____ Depth to top _____ Bottom _____ Total Depth of Well 4365
Show depth and thickness of all water, oil and gas formations.

OIL, GAS OR WATER RECORDS

CASING RECORD

FORMATION	CONTENT	FROM	TO	SIZE	PUT IN	PULLED OUT
Surface Hole	Shale	Surface	194'	8 5/8"	194'	

Describe in detail the manner in which the well was plugged, indicating where the mud fluid
was placed and the method or methods used in introducing it into the hold. If cement or other
plugs were used, state the character of same and depth placed, from _____ feet to
_____ feet for each plug set.

Bottom plug set at 200' w/25 sacks cement;
Top plug set at 40' w/10 sacks cement;
3 sacks cement down rat hole

RECEIVED
STATE CORPORATION COMMISSION

DEC - 7 1978

12-7-78

CONSERVATION DIVISION
Wichita, Kansas

(If additional description is necessary, use BACK of this sheet)

Name of Plugging Contractor Pioneer Drilling Co.

STATE OF Colorado COUNTY OF Denver, ss.
M.J. Wohnlich (employee of owner) or (owner or operator)

of the above-described well, being first duly sworn on oath, says: That I have knowledge of
the facts, statements, and matters herein contained and the log of the above-described well
as filed and that the same are true and correct. So help me God.

(Signature) [Signature]

P.O. Box 36078, Denver, CO 80236
(Address)

SUBSCRIBED AND SWORN TO before me this 4th day of December, 19 78

[Signature]
Notary Public.

My commission expires July 1, 1980

DRILLERS LOG

Derrick-American Oil, Inc.
 Koster #1
 NW NW SE
 Sec. 22-29s-4w
 Sedgwick County, Kansas

Elev. - Not available
 Surface Casing: 194' of 8 5/8"
 Commenced: 11-20-78
 Completed: 12-01-78

<u>FORMATION</u>	<u>DEPTH</u>
Surface Hole	194
Shale	194 - 573
Shale	573 - 792
Shale - Lime	792 - 950
Shale & Lime	950 - 1285
Shale & Lime	1285 - 1591
Shale - Lime St.	1591 - 1950
Shale & Lime	1950 - 2265
Shale & Lime	2265 - 2570
Shale - Lime	2570 - 2810
Shale - Lime	2810 - 3090
Shale & Lime	3090 - 3294
Shale - Lime	3294 - 3434
K.C. Lime	3434 - 3477
Lime	3477 - 3585
Shale - Lime	3585 - 3693
Shale - Lime	3693 - 3723
Shale & Lime	3723 - 3805
Shale & Lime	3805 - 3902
Shale & Lime	3902 - 3946
Mississippi	3946 - 4075
Shale & Lime	4075 - 4185
Shale - Lime St.	4185 - 4258
Shale - Lime	4258 - 4308
Shale & Lime	4308 - 4325
Shale & Lime	4325 - 4365 RTD

RECEIVED
 STATE CORPORATION COMMISSION
 DEC - 7 1978
 CONSERVATION DIVISION
 Wichita, Kansas

I do hereby certify that the foregoing statements are true and correct
 to the best of my knowledge and belief.

PIONEER DRILLING CO.

[Signature]

STATE OF COLORADO)
) ss.
 County of Denver)

Subscribed and sworn to before me this 4th day of December, 1978.

My Commission Expires: July 1, 1980

[Signature]
 Notary Public