


STATE OF KANSAS
STATE CORPORATION COMMISSION

WELL PLUGGING RECORD

Give All Information Completely
Make Required Affidavit
Mail or Deliver Report to
Conservation Division
State Corporation Comm.
245 North Water
Wichita, KS 67202

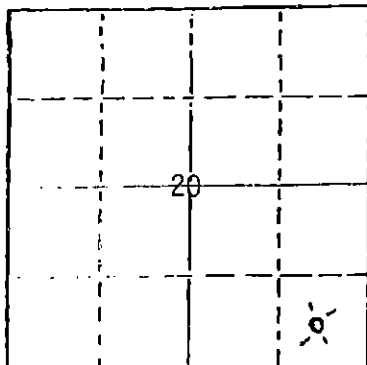

Locate well correctly on above
Section Plot

Sedgwick County. Sec. 20 Twp. 29S Rge. 4W E/W
Location as "NE/CNW $\frac{1}{4}$ SW $\frac{1}{4}$ " or footage from lines C SE SE

Lease Owner W.E. Carl & Associated Petroleum Consultants, Inc.

Lease Name Ramsdale Well No. #1-20

Office Address Suite 600-One Main Place, Wichita, KS 67202

Character of Well (Completed as Oil, Gas or Dry Hole)

Dry Hole

Date Well completed October 29, 1981

Application for plugging filed October 29 1981

Application for plugging approved October 29, 1981

Plugging commenced 11:00 p.m. Oct. 28 19

Plugging completed 1:45 a.m. Oct. 29 19

Reason for abandonment of well or producing formation

D & A

If a producing well is abandoned, date of last production 19

Was permission obtained from the Conservation Division or its agents before plugging was commenced? yes

Name of Conservation Agent who supervised plugging of this well Don Thompson

Producing formation X Depth to top X Bottom X Total Depth of Well 4465

Show depth and thickness of all water, oil and gas formations.

OIL, GAS OR WATER RECORDS

CASING RECORD

FORMATION	CONTENT	FROM	TO	SIZE	PUT IN	PULLED OUT
				8 5/8"	288'	

Describe in detail the manner in which the well was plugged, indicating where the mud fluid was placed and the method or methods used in introducing it into the hold. If cement or other plugs were used, state the character of same and depth placed, from feet to feet for each plug set.

Mud to 300' - 30 sacks Cement

Mud to 60' - 20 sacks Cement

5 sacks Mouse Hole

5 sacks Rat Hole

RECEIVED
STATE CORPORATION COMMISSION

(If additional description is necessary, use BACK of this sheet)

Name of Plugging Contractor State Corporation Commission of Kansas

NOV - 9 1981
11-9-81
CONSERVATION DIVISION
Wichita, Kansas

STATE OF KANSAS COUNTY OF SEDGWICK, ss.
Phyllis Buchanan (employee of owner) or (owner or operator)
of the above-described well, being first duly sworn on oath, says: That I have knowledge of the facts, statements, and matters herein contained and the log of the above-described well as filed and that the same are true and correct. So help me God.

(Signature) Phyllis Buchanan
PHYLLIS BUCHANAN
(Address)

SUBSCRIBED AND SWORN TO before me this 29th day of October, 1981

Sherry Myers
SHERRY MYERS Notary Public.

My commission expires

