


Information Completely
Make Required Affidavit
Mail or Delivery Report to:
Conservation Division
State Corporation Commission
P. O. Box 17027
Wichita, Kansas 67217
NORTH

WELL PLUGGING RECORD

Sedgwick County, Sec. 35 Twp 29S Rge. (E) 3W (W)

Location as "NE/CNWxSWx" or footage from lines NE NW NW
Lease Owner Zenith Drilling Corporation, Inc.
Lease Name Farmer Well No. 1
Office Address 200 W. Douglas, Suite 600, Wichita, Kansas
Character of Well (completed as Oil, Gas or Dry Hole) Dry Hole
Date well completed 10-25-19 73
Application for plugging filed 10-25-19 73
Application for plugging approved 10-25-19 73
Plugging commenced 10-25-19 73
Plugging completed 10-25-19 73
Reason for abandonment of well or producing formation No commercial quantities of oil or gas encountered.
If a producing well is abandoned, date of last production 19
Was permission obtained from the Conservation Division or its agents before plugging was commenced? Yes

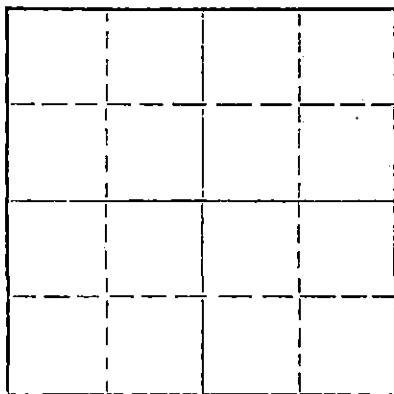

Locate well correctly on above Section Plat

Name of Conservation Agent who supervised plugging of this well Ted Dewey
Producing formation Depth to top Bottom Total Depth of Well 3780 Feet
Show depth and thickness of all water, oil and gas formations.

OIL, GAS OR WATER RECORDS

CASING RECORD

FORMATION	CONTENT	FROM	TO	SIZE	PUT IN	PULLED OUT
Surface Hole	Fluid	Surface	205	8-5/8"	203	None

Describe in detail the manner in which the well was plugged, indicating where the mud fluid was placed and the method or methods used in introducing it into the hole. If cement or other plugs were used, state the character of same and depth placed, from feet to feet for each plug set.

Fluid to 225', plug, 25 sx cement;
Fluid to 40', plug, 10 sx cement;
Two sacks cement in rat hole.

RECEIVED
STATE CORPORATION COMMISSION
NOV 2 1973
CONSERVATION DIVISION
Wichita, Kansas

(If additional description is necessary, use BACK of this sheet)
Name of Plugging Contractor D N B DRILLING, INC.
Address 701 First Nat'l Building, Wichita, Kansas 67202

STATE OF KANSAS, COUNTY OF _____, ss.
JAMES L. DONELSON (employee of owner) or (owner or operator) of the above-described well, being first duly sworn on oath, says: That I have knowledge of the facts, statements, and matters herein contained and the log of the above-described well as filed and that the same are true and correct. So help me God.

(Signature) James L. Donelson
701 First Nat'l Bldg., Wichita, Kansas (Address)

SUBSCRIBED AND SWORN to before me this 31st day of October, 19 73

My commission expires August 25, 1976

Ella Priess

Notary Public.

Ella Priess
STATE NOTARY PUBLIC
Sedgwick County, Kansas
My Com. Expires Aug. 25, 1976

DRILLERS' LOG

ZENITH DRILLING CORPORATION, INC.

No. 1 Farmer
NE NW NW, Sec. 35-29S-3W
Sedgwick County, Kansas

Elevation: 1324 K.B.

Commenced: 10-18-73
Completed: 10-25-73

Surface Casing: 203' of
8-5/8" cemented w/125 sx
cement, 28 cc. 10-13-73

<u>FORMATION</u>	<u>DEPTH</u>
Surface Hole	0 - 205
Shale	205 - 320
Shale & Lime	320 - 2822
Sand	2822 - 2935
Shale & Lime	2935 - 3124
Lime	3124 - 3300
Lime & Shale	3300 - 3401
Lime	3401 - 3516
Lime & Shale	3516 - 3690
Shale & Lime	3690 - 3730
Lime	3730 - 3780 T.D.

I do hereby certify that the foregoing statements are true and correct to the best of my knowledge and belief.

D. N. B. DRILLING, INC.

James L. Donelson
JAMES L. DONELSON

RECEIVED
STATE CORPORATION COMMISSION
NOV 2 1973
CONSERVATION DIVISION
Wichita, Kansas

STATE OF KANSAS: ss:

Subscribed and sworn to before me, the undersigned, a Notary Public in and for said state, this 31st day of October, 1973.

Ella Priess

My Commission Expires:

Ella Priess, Notary Public

Ella Priess
STATE NOTARY PUBLIC
Sedgwick County, Kansas
My Com. Expires Aug. 25, 1976