


STATE OF KANSAS
STATE CORPORATION COMMISSION

Form CP-4

Give All Information Completely
Make Required Affidavit
Mail or Deliver Report to:
Conservation Division
State Corporation Commission
212 No. Market
Wichita, Kansas 67202

WELL PLUGGING RECORD

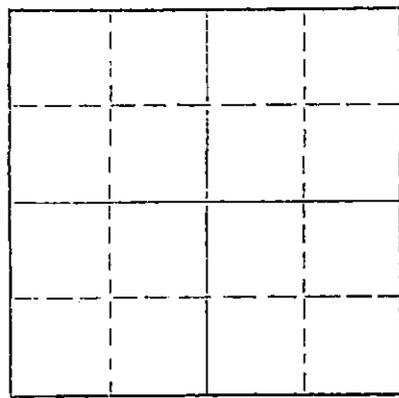

Locate well correctly on above
Section Plat

Sedgwick County, Sec. 27 Twp. 29S Rge. (E) 3 (W) 3
Location as "NE/CNW/SESW" or footage from lines. 1530' E. & 330' N. of SWc
Lease Owner Hummon Oil Company
Lease Name Stinson Well No. 1
Office Address 6409 East 14th St., Wichita, Kansas
Character of Well (completed as Oil, Gas or Dry Hole) Dry Hole
Date well completed 3-30 19 72
Application for plugging filed 3-30 19 72
Application for plugging approved 3-30 19 72
Plugging commenced 3-30 19 72
Plugging completed 3-30 19 72
Reason for abandonment of well or producing formation Dry Hole

If a producing well is abandoned, date of last production 19
Was permission obtained from the Conservation Division or its agents before plugging was commenced? Yes

Name of Conservation Agent who supervised plugging of this well Ted Dewey
Producing formation Depth to top Bottom Total Depth of Well 3820 Feet
Show depth and thickness of all water, oil and gas formations.

OIL, GAS OR WATER RECORDS

CASING RECORD

FORMATION	CONTENT	FROM	TO	SIZE	PUT IN	PULLED OUT
				8 5/8"	279'	- - - -

Describe in detail the manner in which the well was plugged, indicating where the mud fluid was placed and the method or methods used in introducing it into the hole. If cement or other plugs were used, state the character of same and depth placed, from feet to feet for each plug set.

Hole mudded to 275',
1/2 sack Hulls, plug, and 25 sacks cement
Mud to 40'
1/2 sack Hulls, plug, and 10 sacks cement
Rathole capped with 2 sacks cement


RECEIVED
STATE CORPORATION COMMISSION
APR 5 - 1972
CONSERVATION DIVISION
Wichita, Kansas

(If additional description is necessary, use BACK of this sheet)
Name of Plugging Contractor White & Ellis Drilling, Inc.
Address Box 448, El Dorado, Kansas 67042

STATE OF Kansas COUNTY OF Butler ss.
Ernest Sifford (employee of owner) or (owner or operator) of the above-described well, being first duly sworn on oath, says: That I have knowledge of the facts, statements, and matters herein contained and the log of the above-described well as filed and that the same are true and correct. So help me God.

(Signature) Ernest Sifford

(Address) April 4th day of April 19 72

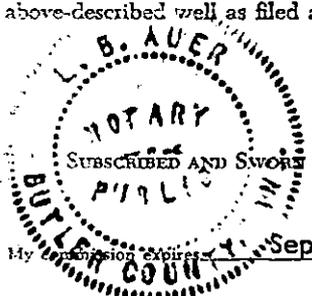

Subscribed and sworn to before me this 4th day of April 19 72
My Commission Expires September 26, 1972

L. B. Auer
Notary Public.

DRILLERS LOG

OPERATOR: HUMMON OIL COMPANY

CONTRACTOR: White & Ellis Drilling, Inc., Box 448, El Dorado, Kansas 67042

Lease Name Stinson Well No. 1

Sec. 27 T. 29S R. 3W Spot 1530' E. & 330' N. of SWc

County Sedgwick State Kansas Elevation _____

Casing Record:

Surface: 8 5/8" @ 279' with 160 Sxs. 3% cc
2% Jell

Production: _____ @ _____ with _____ Sxs.

Type Well: Dry Hole Total Depth 3820' KB

Drilling Commenced: 3-23-72 Drilling Completed 3-30-72

Formation	From	To	Tops	
Clay & Shale	0	60		
Shale & Lime (Stks.)	60	279		
Lime & Shale	279	400	Stalnaker	2870
Shale	400	600	Kansas City	3217
Lime & Shale	600	1130	Mississippi	3783
Lime & Shale (Stks.)	1130	1375		
Lime & Shale	1375	1530		
Shale	1530	1650		
Shale & Lime (Stks.)	1650	2405		
Lime & Shale	2405	2675		
Shale	2675	2820		
Sand	2820	2963		
Shale & Lime	2963	3130		
Shale	3130	3145		
Lime	3145	3355		
Shale & Lime	3355	3778		
Lime	3778	3820		

STATE OF KANSAS
 STATE CORPORATION COMMISSION
 APR 5 - 1972
 CONSERVATION DIVISION
 Topeka, Kansas

COMPLETION RECORD

Liner Record: Size _____ From _____ To _____

Cementing Record: _____ Sacks _____

Perforating Record:

Formation	Perforated Interval	Number Shots

Initial Production: _____

Electric Log _____ Type and Depths Covered _____