


STATE OF KANSAS
STATE CORPORATION COMMISSION

WELL PLUGGING RECORD

Give All Information Completely
Make Required Affidavit,
Mail or Deliver Report to:
Conservation Division
State Corporation Commission
800 Bitting Building
Wichita, Kansas

Pratt County. Sec. 1 Twp. 28S Rge. 12 (6) (W)
Location as "NE/CNW/SW" or footage from lines SE SE SE
Lease Owner Stickle Drilling Company
Lease Name Crosley Well No. 1
Office Address 507 Bitting Building
Character of Well (completed as Oil, Gas or Dry Hole) Dry hole
Date well completed 3 December 19 55
Application for plugging filed 3 December 19 55
Application for plugging approved 3 December 19 55
Plugging commenced 3 December 19 55
Plugging completed 5:30 a.m. December 3, 19 55
Reason for abandonment of well or producing formation Dry

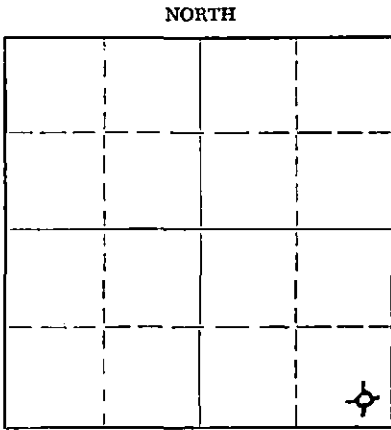

NORTH
Locate well correctly on above
Section Plat

If a producing well is abandoned, date of last production _____ 19____
Was permission obtained from the Conservation Division or its agents before plugging was commenced? Yes

Name of Conservation Agent who supervised plugging of this well Merle Rives, Pratt, Kansas
Producing formation None Depth to top _____ Bottom _____ Total Depth of Well 4595 Feet
Show depth and thickness of all water, oil and gas formations.

OIL, GAS OR WATER RECORDS

CASING RECORD

FORMATION	CONTENT	FROM	TO	SIZE	PUT IN	PULLED OUT
				8 5/8	616'	None

Describe in detail the manner in which the well was plugged, indicating where the mud fluid was placed and the method or methods used in introducing it into the hole. If cement or other plugs were used, state the character of same and depth placed, from _____ feet to _____ feet for each plug set.

Mud to 300 feet - wooden plug - 35 sacks common cement - mud to 35 feet - wooden plug - one half sack hulls - 15 sacks cement.

12-28-55

(If additional description is necessary, use BACK of this sheet)
Name of Plugging Contractor Stickle Drilling Company
Address 507 Bitting Building, Wichita, Kansas

STATE OF Kansas, COUNTY OF Sedgwick, ss.
R.B. Parriott (employee of owner) or (owner or operator) of the above-described well, being first duly sworn on oath, says: That I have knowledge of the facts, statements, and matters herein contained and the log of the above-described well as filed and that the same are true and correct. So help me God.

(Signature) R. B. Parriott
507 Bitting Building, Wichita, Kansas
(Address)

SUBSCRIBED AND SWORN TO before me this 12th day of December, 19 55

My commission expires August 22, 1957
Gladys Thomas
Notary Public

PLUGGING
FILE DEC 17 28 12 W
PAGE 22 LINE 18

Stickle Drilling Company
Tulsa, Oklahoma

Sec 1-28-12W
SESESE


CONTRACTOR: Stickle Drilling Company
Drilling Commenced: November 12, 1955
Drilling Completed: December 3, 1955

December 12, 1955

DRILLERS LOG

Sand & Shale	0-245
Shale & Shells	245-575
Red Bed	575-606
Anhydrite	606-635
Red Bed & Shale	635-685
Shale & Shells	685-1710
Lime & Shale	1710-1765
Lime	1765-2485
Shale & Lime	2485-3390
Lime	3390-3612
Lime & Shale	3612-3684
Shale	3684-3698
Lime	3698-3762
Lime & Shale	3762-3800
Lime	3800-3981
Lime & Chert	3981-4010
Lime	4010-4071
Lime & Shale	4071-4133
Lime	4133-4150
Lime & Shale	4150-4200
Lime	4200-4217
Hard Lime	4217-4229
Lime & Shale	4229-4250
Lime	4250-4260
Shale & Lime	4260-4287
Lime & Shale	4287-4323
Lime Shale & Chert	4323-4363
Lime (Viola)	4363-4380
Lime & Chert	4380-4430
Lime & Shale	4430-4455
Shale & Sand	4455-4469
Hard Sand	4469-4491
Shale & Sand	4491-4518
Shale & Sand Streaks	4518-4550
Shale & Lime	4550-4566
Lime	4566-4595 TD

I, R.B. Parriott hereby certify the above to be a true and complete Drillers Log of Stickle Drilling Company's #1 Crosley SE SE SE Section 1-28S-12W, Pratt County, Kansas.

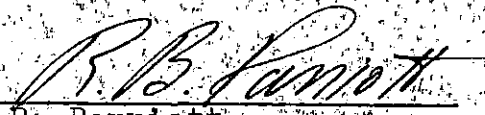
R.B. Parriott


Notary Public

August 22, 1957
My Commission Expires

