


STATE OF KANSAS
STATE CORPORATION COMMISSION

WELL PLUGGING RECORD

Give All Information Completely
Make Required Affidavit
Mail or Deliver Report to
Conservation Division
State Corporation Comm.
245 North Water
Wichita, KS 67202

Pratt County. Sec. 29 Twp. 28S Rge. 11W E/W
Location as "NE/CNW $\frac{1}{4}$ SW $\frac{1}{4}$ " or footage from lines
SE SE NW

Lease Owner Raymond Oil Company
Lease Name Dietz Well No. 1
Office Address 200 West Douglas, Suite 800, Wichita, Ks 67202
Character of Well (Completed as Oil, Gas or Dry Hole)
Dry Hole

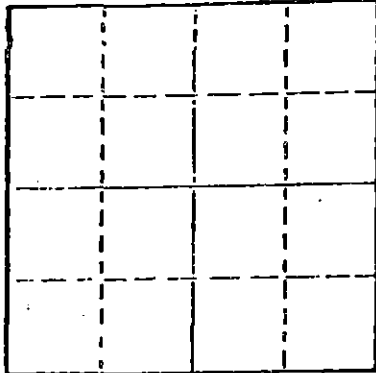

Locate well correctly on above
Section Plot

Date Well completed October 24 1977
Application for plugging filed October 24 1977
Application for plugging approved October 24 1977
Plugging commenced October 24 1977
Plugging completed October 24 1977
Reason for abandonment of well or producing formation
Dry

If a producing well is abandoned, date of last production
19

Was permission obtained from the Conservation Division or
its agents before plugging was commenced? Yes

Name of Conservation Agent who supervised plugging of this well Bill Owen
Producing formation Depth to top Bottom Total Depth of Well
Show depth and thickness of all water, oil and gas formations.

OIL, GAS OR WATER RECORDS

CASING RECORD

FORMATION	CONTENT	FROM	TO	SIZE	PUT IN	PULLED OUT
		0	254	8 5/8	254	None

Describe in detail the manner in which the well was plugged, indicating where the mud fluid
was placed and the method or methods used in introducing it into the hold. If cement or other
plugs were used, state the character of same and depth placed, from feet to
feet for each plug set.

RECEIVED
STATE CORPORATION COMMISSION
OCT 27 1977
CONSERVATION DIVISION
Wichita, Kansas

Plugged: 40 sacks @ 500;
35 sacks @ 250;
Mud up to 40'
1/2 sack hulls plug 12 sacks cement
Halliburton cement

(If additional description is necessary, use BACK of this sheet)

Name of Plugging Contractor DaMac Drilling Inc.
Box 1164, Great Bend, Kansas 67530


STATE OF Kansas COUNTY OF Barton ss.
Martha J. McKown (employee of owner) or (owner or operator) of the above-described
well, being first duly sworn on oath, says: That I have knowledge of the facts, statements, and matters herein contained and the log of the
above-described well as filed and that the same are true and correct. So help me God.

(Signature) Martha J. McKown
Box 1164, Great Bend, Kansas 67530
(Address)

Subscribed and sworn to before me this 25th day of October 1977

Lana L. Remmert
Notary Public

My commission expires 4-28-81

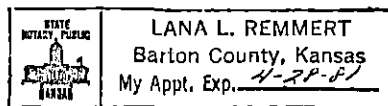

Operator Raymond Oil Company DESIGNATE TYPE OF COMP.: OIL, GAS, DRY HOLE, SWDW, ETC.:

Well No. 1 Lease Name Dietz Dry Hole

S 29 T 28S R 11W^E

WELL LOG
 Show all important zones of porosity and contents thereof; cored intervals, and all drill-stem tests, including depth interval tested, cushion used, time tool open, flowing and shut-in pressures, and recoveries.
 SHOW GEOLOGICAL MARKERS, LOGS RUN, OR OTHER DESCRIPTIVE INFORMATION.

FORMATION DESCRIPTION, CONTENTS, ETC.	TOP	BOTTOM	NAME	DEPTH
Surface Sand, Clay, Shells	0	220		
RedBed	220	254		
Shale, RedBed	254	885		
Shale	885	1625		
Shale, Lime	1625	2813RTD		

RECEIVED
 STATE CORPORATION COMMISSION
 OCT 27 1977
 CONSERVATION DIVISION
 Wichita, Kansas

USE ADDITIONAL SHEETS, IF NECESSARY, TO COMPLETE WELL RECORD.

Date Received _____

 Signature
 Vice President

 Title
 October 25, 1977

 Date