


STATE OF KANSAS  
STATE CORPORATION COMMISSION

WELL PLUGGING RECORD

Give All Information Completely  
Make Required Affidavit  
Mail or Deliver Report to  
Conservation Division  
State Corporation Comm.  
245 North Water  
Wichita, KS 67202

Pratt County. Sec. 28 Twp. 28 Rge. 11 E/W  
Location as "NE/CNW $\frac{1}{4}$ /SW $\frac{1}{4}$ " or footage from lines  
C S/2 S/2

Lease Owner Raymond Oil Co., Inc.  
Lease Name WILLINGER Well No. 2  
Office Address Suite 800, 200 West Douglas, Wichita, Ks.  
Character of Well (Completed as Oil, Gas or Dry Hole) Dry Hole

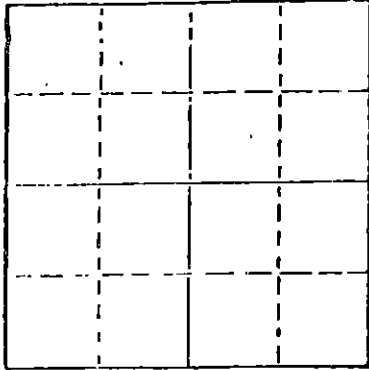

Locate well correctly on above  
Section Plot

Date Well completed 2-14-1979  
Application for plugging filed 2-14-1979  
Application for plugging approved 2-14-1979  
Plugging commenced 2-14-1979  
Plugging completed 2-14-1979  
Reason for abandonment of well or producing formation

If a producing well is abandoned, date of last production 19\_\_

Was permission obtained from the Conservation Division or its agents before plugging was commenced? yes

Name of Conservation Agent who supervised plugging of this well William Owens  
Producing formation \_\_\_\_\_ Depth to top \_\_\_\_\_ Bottom \_\_\_\_\_ Total Depth of Well 2670'  
Show depth and thickness of all water, oil and gas formations.


OIL, GAS OR WATER RECORDS

CASING RECORD

FORMATION	CONTENT	FROM	TO	SIZE	PUT IN	PULLED OUT

Describe in detail the manner in which the well was plugged, indicating where the mud fluid was placed and the method or methods used in introducing it into the hold. If cement or other plugs were used, state the character of same and depth placed, from \_\_\_\_\_ feet to \_\_\_\_\_ feet for each plug set.

Bottom plug @ 540' w/50 sacks 50/50 pozmix thru d.p.  
Middle plug @ 210' w/40 sacks of " " " "  
Tope Plug @ 40' w/solid bridge and 12 sacks cement.  
3 sacks cement in rat hole

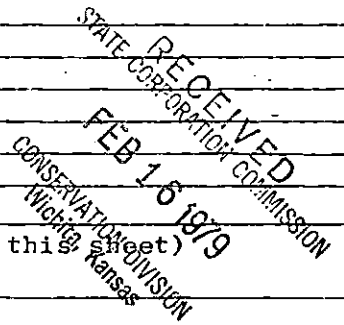

(If additional description is necessary, use BACK of this report)

Name of Plugging Contractor Duke Drilling Co., Inc.

STATE OF Kansas COUNTY OF Barton, ss.  
Bill Draney (employee of owner) or \_\_\_\_\_  
of the above-described well, being first duly sworn on oath, says: That I have knowledge of the facts, statements, and matters herein contained and the log of the above-described well as filed and that the same are true and correct. So help me God.

(Signature) Bill Draney  
Box 823 - Great Bend, Ks. 67530  
(Address)

SUBSCRIBED AND SWORN TO before me this 14 day of February, 1979

Dorothy M. Hague  
Notary Public.

My commission expires April 11, 1982

DRILLERS' WELL LOG

DATE COMMENCED: February 10, 1979  
DATE COMPLETED: February 14, 1979

Raymond Oil Co., Inc.  
WILLINGER #2  
C 3/2 S/2 Sec 28-128-R11W  
Pratt County, Kansas

0 - 69' Sand  
69 - 160' Sand w/shale streaks  
160 - 208' Shale & Red Bed  
208 - 1682' Shale  
1682 - 2596' Shale & Lime  
2596 - 2621' Sand  
2621 - 2670' Lime & Shale  
2670' RTD

ELEVATION: 1801 K.B.

FORMATION DATA

INDIAN GAVE 2596  
RTD 2670

SURFACE PIPE: Set new 6-5/8" pipe, 2 1/2" @ 208' with 160 sacks cement, 2 1/2 Gal, 3% cc.

AFFIDAVIT

STATE OF KANSAS  
COUNTY OF BARTON ) SS.

Bill Draney of lawful age does swear and state that the facts and statements herein contained are true and correct to the best of his knowledge.

Bill Draney

Subscribed and sworn to before me this 14th day of February 1979

My Comm. Expires:  
April 11 1982

Dorothy M. Hague  
Notary Public

RECEIVED  
STATE CORPORATION COMMISSION  
FEB 16 1979  
CONSERVATION DIVISION  
Wichita, Kansas