


WELL PLUGGING RECORD

Give All Information Completely
Make Required Affidavit
Mail or Deliver Report to:
Conservation Division
State Corporation Commission
800 Biting Building
Wichita, Kansas

Pratt County, Sec. 27 Twp. 28 Rge. 11 (E) W (W)

NORTH

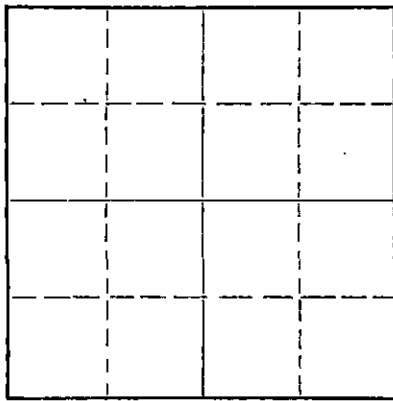

Locate well correctly on above Section Plat

Location as "NE/CNW/SW" or footage from lines NW NW NE
Lease Owner Trans Era Petroleum, Inc.
Lease Name Rose Well No. 1
Office Address Russell, Kansas
Character of Well (completed as Oil, Gas or Dry Hole) Dry Hole
Date well completed 2/25/55 19
Application for plugging filed 2/24/55 19
Application for plugging approved 2/24/55 19
Plugging commenced 2/25/55 19
Plugging completed 2/25/55 19
Reason for abandonment of well or producing formation Dry Hole

If a producing well is abandoned, date of last production _____ 19____
Was permission obtained from the Conservation Division or its agents before plugging was commenced? Yes

Name of Conservation Agent who supervised plugging of this well M. G. Rives
Producing formation _____ Depth to top _____ Bottom _____ Total Depth of Well 4595 Feet
Show depth and thickness of all water, oil and gas formations.

OIL, GAS OR WATER RECORDS

CASING RECORD

FORMATION	CONTENT	FROM	TO	SIZE	PUT IN	PULLED OUT
				8 5/8"	310'	None

Describe in detail the manner in which the well was plugged, indicating where the mud fluid was placed and the method or methods used in introducing it into the hole. If cement or other plugs were used, state the character of same and depth placed, from _____ feet to _____ feet for each plug set.

PLUGGING RECORD

Finish laying down pipe, filled hole with heavy mud to 305', set plug at 305' with 20 sacks of cement on plug. Filled hole with mud to 40', set plug at 40' with one-fourth sack of hulls and 10 sacks of cement used.

RECEIVED
STATE CORPORATION COMMISSION

FEB 25 1955
CONSERVATION DIVISION
WICHITA, KANSAS

(If additional description is necessary, use BACK of this sheet)

Name of Plugging Contractor Trans Era Petroleum, Inc.
Address Russell, Kansas

STATE OF KANSAS, COUNTY OF RUSSELL, ss.
H. R. Michaelis (employee of owner) or (owner or operator) of the above-described well, being first duly sworn on oath, says: That I have knowledge of the facts, statements, and matters herein contained and the log of the above-described well as filed and that the same are true and correct. So help me God.

(Signature) H. R. Michaelis
Russell, Kansas
(Address)

SUBSCRIBED AND SWORN TO before me this 2nd day of March, 19 55

My commission expires 1-30-57

Margie Cooper
Notary Public.

PLUGGING
FILE SEC 27 28 R 11 W
BOOK PAGE 100 LINE 5

Trans Era Petroleum, Inc.
Rose #1

NW NW NE 27-28-11
Pratt County, Ks.

Total Depth: 4595'
Comm. 2/5/55
Comp. 2/25/55

Casing

Cement

8 5/8" Set @ 310'

230 sacks of Portland

FORMATION

DEPTH

Sand	95
Shale-shells	180
Red bed	580
Shale-shells	1365
Salt	1440
Anhydrite	1470
Shale-shells	1575
Lime-shale	3690
Lime	3926
Lime-shale	3985
Lime	4110
Lime-chert	4142
Mississippi lime	4150
Shale (Kinderhook	4157
Shale-lime	4185
Shale	4317
Lime-chert	4333
Lime	4399
Shale-sand	4415
Shale	4425
Shale-sand	4460
Sand	4470
Shale-sand	4515
Shale	4543
Arkuckle	4560
Lime	4595'

STATE OF KANSAS)
) ss
RUSSELL COUNTY)

I hereby certify that the above information is true and correct to the best of my knowledge.

_____ *Cora Betz* _____

Subscribed and sworn to before me this 2nd day of March, 1955.

_____ *Margie Cooper* _____
Notary Public

My commission expires: 1-30-57.

RECORDED
FILED DEC 27 1955
COURT HOUSE
PRATT, KANSAS