

15-191-20259-0000

STATE OF KANSAS
STATE CORPORATION COMMISSION


Form CP-4

R

Give All Information Completely
Make Required Affidavit
Mail or Deliver Report to:
Conservation Division
State Corporation Commission
212 No. Market
Wichita, Kansas

WELL PLUGGING RECORD

NORTH

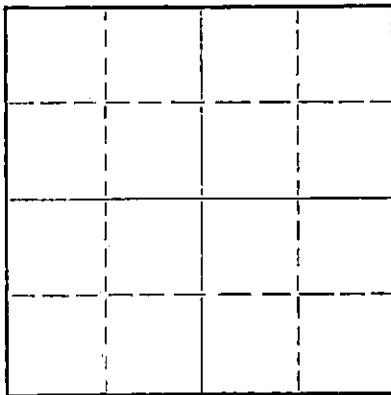

Locate well correctly on above
Section Plat

Sumner County, Sec. 32nd Twp. 30S Rge. 3W (E) (W)
Location as "NE/CNW/SW" or footage from lines NW C NW SW
Lease Owner Mack Oil Company
Lease Name Hilger Well No.
Office Address 812 Union Center, Wichita, Kansas 67202
Character of Well (completed as Oil, Gas or Dry Hole) Dry Hole
Date well completed 3-24 1971
Application for plugging filed 3-24 1971
Application for plugging approved 3-24 1971
Plugging commenced 3-24 1971
Plugging completed 3-24 1971
Reason for abandonment of well or producing formation Dry Hole

If a producing well is abandoned, date of last production 19
Was permission obtained from the Conservation Division or its agents before plugging was commenced? Yes

Name of Conservation Agent who supervised plugging of this well G. R. Biberstein
Producing formation Depth to top Bottom Total Depth of Well 4376 Feet
Show depth and thickness of all water, oil and gas formations.

OIL, GAS OR WATER RECORDS

CASING RECORD

FORMATION	CONTENT	FROM	TO	SIZE	PUT IN	PULLED OUT
				8 5/8"	243'	

Describe in detail the manner in which the well was plugged, indicating where the mud fluid was placed and the method or methods used in introducing it into the hole. If cement or other plugs were used, state the character of same and depth placed, from feet to feet for each plug set.

Plug @ 240' and 35 sacks cement
Plug @ 40' and 10 sacks
Rathole capped with 2 sacks cement


RECEIVED
STATE CORPORATION COMMISSION
MAR 31 1971
CONSERVATION DIVISION
Wichita, Kansas

(If additional description is necessary, use BACK of this sheet)
Name of Plugging Contractor Thomas Drilling
Address Duncan, Oklahoma

STATE OF KANSAS, COUNTY OF SEDGWICK, ss.
(employee of owner) or (owner or operator) of the above-described well, being first duly sworn on oath, says: That I have knowledge of the facts, statements, and matters herein contained and the log of the above-described well as filed and that the same are true and correct. So help me God.

(Signature) Eldon J. Scherby
812 Union Center, Wichita, Kansas
(Address) 67202

Subscribed and sworn to before me this 29th day of March, 1971

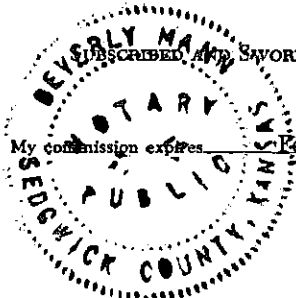

My commission expires Feb. 10, 1975

Beverly Mann
Notary Public.

R

RECEIVED
STATE CORPORATION COMMISSION
MAR 30 1971
CONSERVATION DIVISION
Wichita, Kansas

MACK OIL COMPANY
Duncan, Oklahoma
73533

DRILLERS WELL LOG

#1 Hilger 150' NW of C NW SW - SECTION 32-30S-3W
Sumner County, Kansas
Commenced R.D.: 3-15-71 Elevation: 1391' K.B.
Completed R.D.: 3-24-71 Initial Production: Dry
Rotary Total Depth: 4378' Contractor: Thomas Drilling Company, Inc.

STRATA	DEPTH
Redbed & Shale	0 - 250
Shale	250 - 1155
Shale & Lime	1155 - 1380
Lime	1380 - 1680
Lime & Shale	1680 - 1940
Shale	1940 - 2365
Lime & Shale	2365 - 2874
Lime & Sand	2874 - 3146
Lime & Shale	3146 - 3399
Lime	3399 - 3554
Lime & Shale	3554 - 3722
Lime	3722 - 3885
Lime & Chert	3885 - 3967
Lime	3967 - 4353
Sand	4353 - 4378

I hereby certify that the above is a true and correct log of said well as reflected by the daily drilling reports.

MACK OIL COMPANY

By Eldon J. Schierling
Eldon J. Schierling

Signed and sworn to in my presence this 29th day of March, 1971, by Eldon J. Schierling, representative of Mack Oil Company.



Beverly Mann
Beverly Mann, Notary Public