

15-095-01004-0000

STATE OF KANSAS  
STATE CORPORATION COMMISSION


WELL PLUGGING RECORD

Give All Information Completely  
Make Required Affidavit  
Mail or Deliver Report to:  
Conservation Division  
State Corporation Commission  
211 No. Broadway  
Wichita, Kansas

Kingman County. Sec. 25 Twp. 30S Rge. 5W (E) (W)

Location as "NE/CNWxSWx" or footage from lines. NE NW NW  
Lease Owner Herndon Drilling Company  
Lease Name Bogle Well No. 1  
Office Address Tulsa, Oklahoma  
Character of Well (completed as Oil, Gas or Dry Hole) Dry Hole  
Date well completed 10-19-58 19  
Application for plugging filed 10-19-58 19  
Application for plugging approved 10-19-58 19  
Plugging commenced 10-20-58 19  
Plugging completed 10-20-58 19  
Reason for abandonment of well or producing formation

NORTH

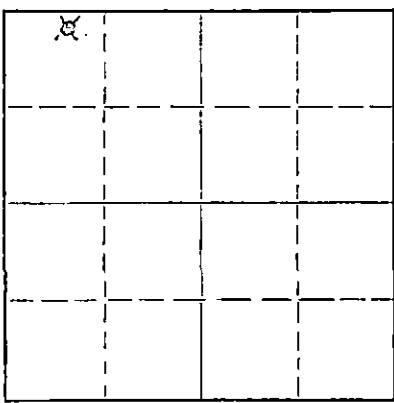

Locate well correctly on above Section Plat

If a producing well is abandoned, date of last production, 19  
Was permission obtained from the Conservation Division or its agents before plugging was commenced? Yes

Name of Conservation Agent who supervised plugging of this well Frank Broadfoot, St. John, Kansas  
Producing formation Depth to top Bottom Total Depth of Well 4637 Feet  
Show depth and thickness of all water, oil and gas formations.

OIL, GAS OR WATER RECORDS

CASING RECORD

| FORMATION | CONTENT | FROM | TO | SIZE | PUT IN | PULLED OUT |
|-----------|---------|------|----|------|--------|------------|
|           |         |      |    |      |        |            |
|           |         |      |    |      |        |            |
Describe in detail the manner in which the well was plugged, indicating where the mud fluid was placed and the method or methods used in introducing it into the hole. If cement or other plugs were used, state the character of same and depth placed, from 240 feet to 35 feet for each plug set.

Well was filled to 240' w/rotary drilling mud  
1/2 sx. of hulls was used to bridge plug. Set @ 240 ft. Cemented w/35 sx. Common  
Cement. Hole was filled to 35 ft. R.T.M. bridged and plug set @ 35 ft. 15 sx.  
mixed and filled to bottom of cellar.

RECEIVED  
STATE CORPORATION COMMISSION  
NOV 8 1958  
CONSERVATION DIVISION  
Wichita, Kansas

Name of Plugging Contractor Halliburton Cementing Co.  
Address Pratt, Kansas  
(If additional description is necessary, use BACK of this sheet)

STATE OF Oklahoma, COUNTY OF Tulsa, ss.  
Tom Elliott (employee of owner) or (owner or operator) of the above-described well, being first duly sworn on oath, says: That I have knowledge of the facts, statements, and matters herein contained and the log of the above-described well as filed and that the same are true and correct. So help me God.

(Signature) Tom Elliott

(Address)

SUBSCRIBED AND SWORN to before me this 22nd day of October, 19 58

My commission expires June 19, 1961

Johann Alene Reese  
Notary Public.

PLUGGING  
FILE SEC. 25 T. 30 R. 5W  
BOOK PAGE 443 LINE 1

### WELL LOG

Well: **BOGLE NO. 1**  
 Location: **NE NW NW, Section 25-30S-5W**  
**Kingman County, Kansas**  
 Owner: **Herndon-Home-Stake-Eates**

Spudding date: **10-2-58**  
 Date casing set: **10-3-58**  
 Date rotary completed: **10-20-58**  
 Date cable completed:

| FROM | TO   | FORMATION        | REMARKS  |
|------|------|------------------|--|
| 0    | 354  | Surface Hole     | Ran 11 Jts. new 8-5/8" Lone Star 24# JF Casing. Set @ 354', Cemented w/325 sx. Common Cement 2% CC.                        |
| 354  | 1200 | Shale and Shells |  |
| 1200 | 3290 | Lime and Shale   |  |
| 3290 | 3302 | Sand and Shale   |  |
| 3302 | 3410 | Sand             |  |
| 3410 | 3585 | Lime and Shale   |  |
| 3585 | 3750 | Lime             |  |
| 3750 | 3845 | Lime and Shale   |  |
| 3845 | 3900 | Lime             |  |
| 3900 | 4195 | Lime and Shale   |  |
| 4195 | 4390 | Lime and Chert   |  |
| 4390 | 4440 | Lime             |  |
| 4440 | 4515 | Lime and Shale   |  |
| 4515 | 4585 | Lime             |  |
| 4585 | 4620 | Lime and Shale   |  |
| 4620 | 4637 | Lime             | Hole filled to 240' w/Rotary mud. 35 sx. cement on top of bridge. Hole filled to 35'. Filled with cement below plow depth. |
|      | 4637 | T.D.             |  |

REL  
 STATE CORPOR  
 NOV 8 1958  
 CONSERVATION DIVISION  
 Wichita, Kansas

Subscribed and sworn to before me this 27 day of October, 19 59

I certify the above and foregoing to be a true and exact copy of the original driller's log on the BOGLE NO. 1

HERNDON DRILLING COMPANY

*Johnnie Allen Jones*  
 Notary Public  
 My commission expires:

By: *C. J. Moore*  
 Title:

June 19, 1961

PLUGGING Asst. Secretary  
 FILE SEC. 25 T. 30 R. 5W  
 BOOK PAGE 143 LINE 1