

STATE OF KANSAS  
STATE CORPORATION COMMISSION  
200 Colorado Derby Building  
Wichita, Kansas 67202

WELL PLUGGING RECORD  
K.A.R.-82-3-117

15-095-01859-0000  
API NUMBER N/A

LEASE NAME Ravenstein

WELL NUMBER C-1

SPOT LOCATION NE-NE

SEC. 4 TWP. 30S RGE. 6 (W)

COUNTY Kingman

Date Well Completed 1964

Plugging Commenced 8/19/85

Plugging Completed 8/23/85

TYPE OR PRINT  
NOTICE: Fill out completely  
and return to Cons. Div.  
office within 30 days.

LEASE OPERATOR Pickrell Drilling Co.

ADDRESS 110 N. Market, Suit 205, Wichita, KS 67202

PHONE # (316) 262-8427 OPERATORS LICENSE NO. 5123

Character of Well Oil  
(Oil, Gas, D&A, SWD, Input, Water Supply Well)

Did you notify the KCC/KDHE Joint District Office prior to plugging this well? yes

Which KCC/KDHE Joint Office did you notify? Wichita, KS

Is ACO-1 filed? \_\_\_\_\_ If not, is well log attached? \_\_\_\_\_

Producing formation \_\_\_\_\_ Depth to top \_\_\_\_\_ bottom \_\_\_\_\_ T.D. 4488

Show depth and thickness of all water, oil and gas formations.

OIL, GAS OR WATER RECORDS | CASING RECORD

| Formation | Content | From | To | Size   | Put in | Pulled out |
|-----------|---------|------|----|--------|--------|------------|
|           |         |      |    | 10 3/4 | 203    | None       |
|           |         |      |    | 5 1/2  | 3763   | 2900       |
|           |         |      |    |        |        |            |
|           |         |      |    |        |        |            |

Describe in detail the manner in which the well was plugged, indicating where the mud fluid was placed and the method or methods used in introducing it into the hole. If cement or other plugs were used state, the character of same and depth placed, from feet to feet each set. Plug back 3735, sand from 3735 to 3535, 5sx cement from 3535 to 3500, pump in 3sx hulls, 15sx fell, plug, 150sx cement, 60-40 POZ

Aumiller and Kirkpatric on location  
(If additional description is necessary, use BACK of this form.)

Name of Plugging Contractor Clarke Corp. License No. 5105  
Address P.O. Box 187, Medicine Lodge, KS 67104

STATE OF Kansas COUNTY OF Barber, ss.

Elmo Morgenstern (employee of operator) or (operator) of above-described well, being first duly sworn on oath, says: That I have knowledge of the facts, statements, and matters herein contained and the log of the above-described well as filed that the same are true and correct, so help me God.

CAREN J. McCULLOUGH  
NOTARY PUBLIC  
STATE OF KANSAS  
My Appt. Exp. 6-29-87

(Signature) [Signature]  
(Address) Medicine Lodge, KS 67104

SUBSCRIBED AND SWORN TO before me this 26 day of August, 1985

My Commission expires: June 29, 1987

RECEIVED  
STATE CORPORATION COMMISSION  
[Signature]  
Notary Public


AUG 28 1985

New Completion  Workover

Oil Company \_\_\_\_\_ Well No. 1 Field Rosedale Lease Ravenstein "C"  
Company Man \_\_\_\_\_ Date Drilled 1964 County Kingman State Ks

Zone Tops & Bottoms

- 203' Base Surface Csg (10 3/4")
- 685' Top of Salt
- 970' Base of Salt
- 3021 Heebner
- 3375 T.O.C. on 5 1/2" Csg.
- 3585 1/2 Top of Perfs
- 3688 Btm. of Perfs
- 3734 PBTD
- 3763 Base 5 1/2" w/100 Sx

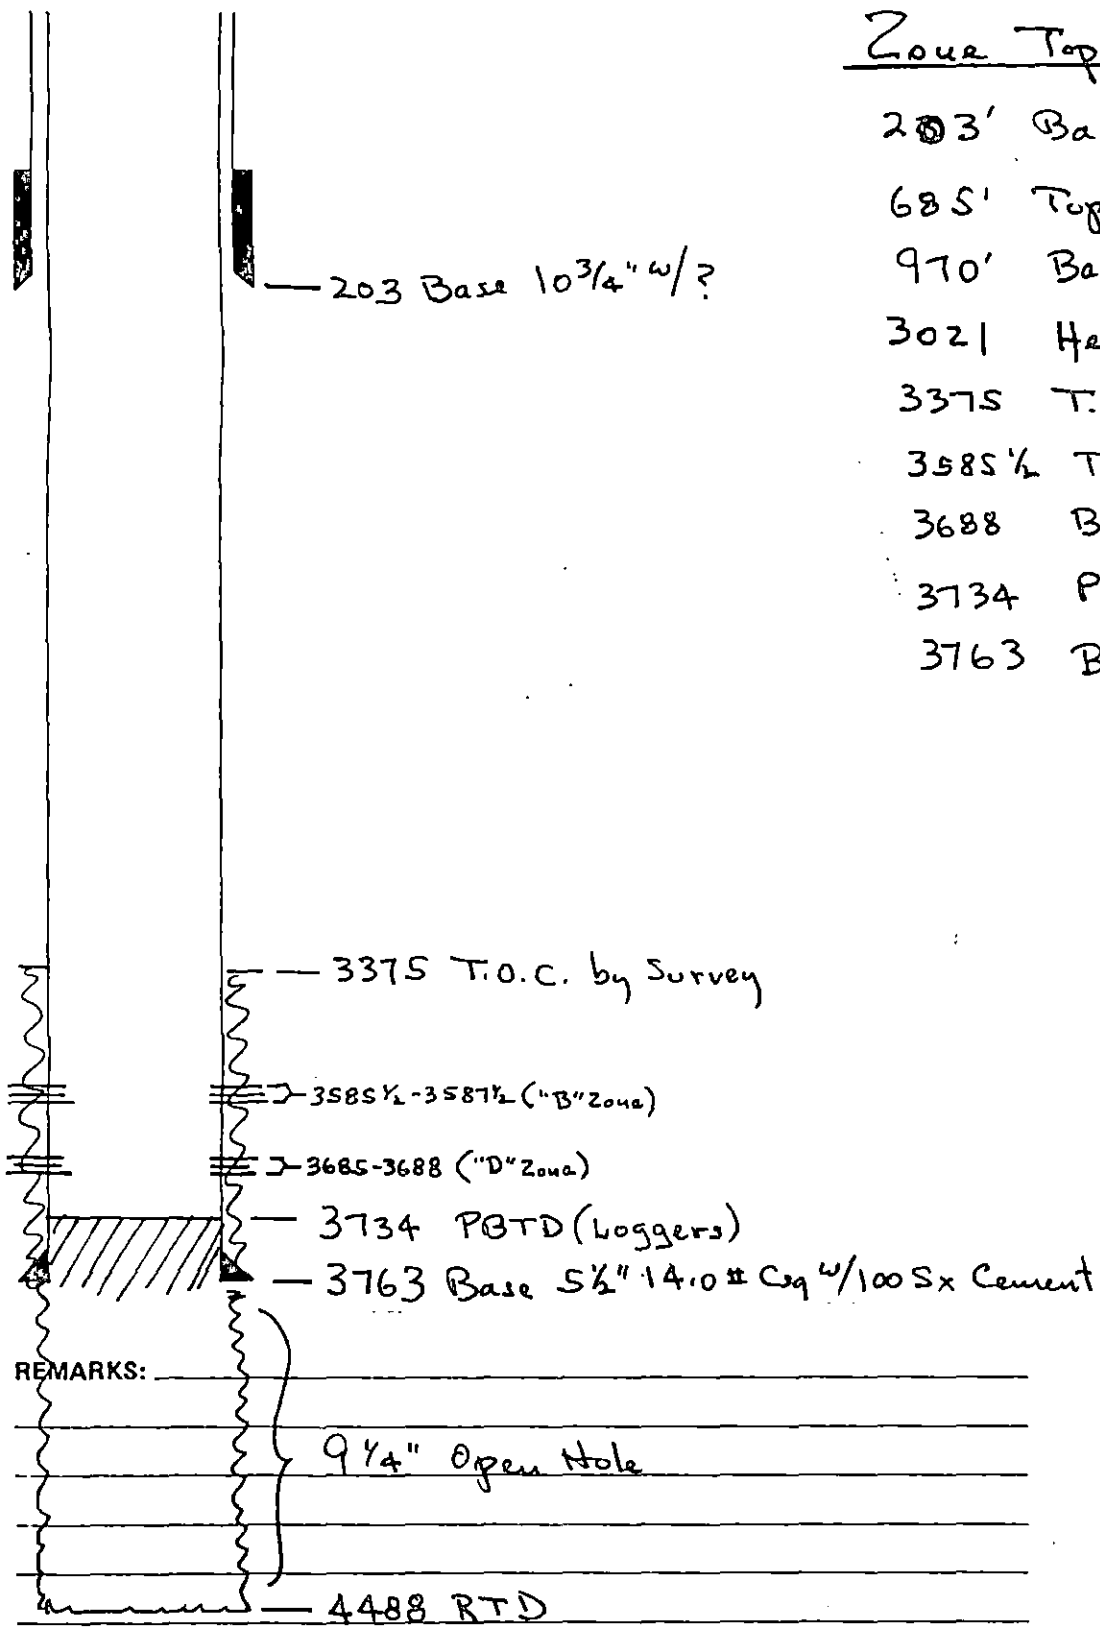

REMARKS:

9 1/4" Open Hole

4488 RTD

RECEIVED  
STATE CORPORATION COMMISSION

MAY 17 1985

CONYER, VEGH DIVISION  
Wichita, Kansas