JUN 30 1982

Form CP-4
Rev. 12-15-80

STATE OF KANSAS
STATE CORPORATION COMMISSION
200 Colorado Derby Bldg.
Wichita, Kansas 67202

15-151-21152-00-00

WELL PLUGGING RECORD

Give All Information Completely
Make Required Affidavit

COUNTY Pratt SEC. 16 TWP. 27S RGE. 15W E/W
Location as in quarters or footage from lines:
SW SW SE

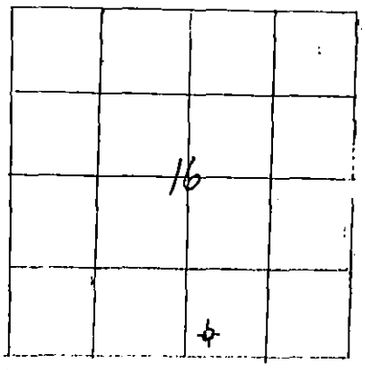

Locate Well correctly on above Section Platt.

Lease Owner Gear Petroleum Company, Inc.
Lease Name Lemon Well No. 1-16
Office Address 300 Sutton Place, Wichita, Ks. 67202.
Character of Well (Completed as Oil, Gas or Dry Hole): Dry.
Date Well Completed 06-23-82
Application for plugging filed 06-22-82
Plugging commenced 06-23-82
Plugging completed 06-23-82
Reason for abandonment of well or producing formation Dry hole.

Was permission obtained from the Conservation Division or it's Agent's before plugging was commenced? Yes.

Name of Conservation Agent who supervised plugging of this well Maurice V. Leslie
Producing formation n/a Depth to top n/a bottom n/a T.D. 4665'
Show depth and thickness of all water, oil and gas formations.

OIL, GAS OR WATER RECORDS — Casing Record

Formation	Content	From	To	Size	Put in	Pulled Out
				8-5/8"	414.26'	-0-

Describe in detail the manner in which the well was plugged, indicating where the mud fluid was placed and the method or methods used in introducing it into the hold. If cement or other plugs were used, state the character of same and depth placed, from _____ feet to _____ feet for each plug set.

1st Plug @ 950' with 60 sx cement
2nd " " 410' " 40 " "
3rd " " 40' " 10 " " and bridge
10 sx of cement in rat hole - 2% gel, 3% cc.

(If additional description is necessary, use BACK of this sheet)

Name of Plugging Contractor Allied Cementing Company
Box 31, Russell, Ks. 67665.

STATE OF Kansas COUNTY OF Sedgwick ,ss.
Jim Thatcher, Drilling & Production Mgr. (Employee of owner) or (owner or operator) of the above-described well, being first duly sworn on oath, says: That I have knowledge of the facts, statements, and matters herein contained and the log of the above-described well as filed and that the same are true and correct. So help me God.

RECEIVED
STATE CORPORATION COMMISSION
JUL 9 1982
CONSERVATION DIVISION
Wichita, Kansas

(Signature) Jim Thatcher
300 Sutton Place, Wichita Ks 67202
(Address)

SUBSCRIBED AND SWORN TO before me this 8th day of July, 19 82

Helen L Coyer
Notary Public.

My Commission expires: April 1, 1982

HELEN L. COYER
NOTARY PUBLIC
STATE OF KANSAS
My Appt. Exp. 4-1-86