


STATE OF KANSAS
STATE CORPORATION COMMISSION

Give All Information Completely
Make Required Affidavit
Mail or Deliver Report to:
Conservation Division
State Corporation Commission
211 No. Broadway
Wichita, Kansas

WELL PLUGGING RECORD

NORTH

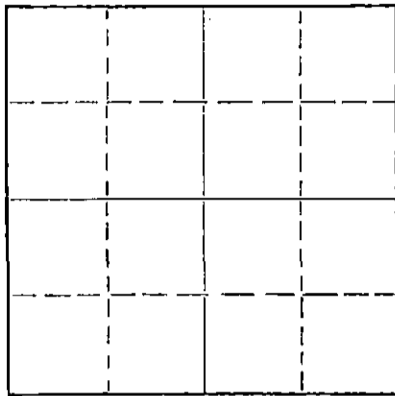

Locate well correctly on above
Section Plat

Pratt County, Sec. 15 Twp. 27S Rge. 15 (N) (W)

Location as "NE/CNW*SW*" or footage from lines SW SW NE

Lease Owner National Associated Petroleum Company

Lease Name Earlywine Well No. 1

Office Address 502 Ritz Building, Tulsa, Oklahoma

Character of Well (completed as Oil, Gas or Dry Hole) Dry hole

Date well completed March 17, 1958

Application for plugging filed Verbal Application March 17, 1958

Application for plugging approved March 17, 1958

Plugging commenced March 17, 1958

Plugging completed March 17, 1958

Reason for abandonment of well or producing formation Dry hole

If a producing well is abandoned, date of last production _____ 19____

Was permission obtained from the Conservation Division or its agents before plugging was commenced? Yes

Name of Conservation Agent who supervised plugging of this well W. L. Lac Kamp, Jr.

Producing formation _____ Depth to top _____ Bottom _____ Total Depth of Well 4630 Feet

Show depth and thickness of all water, oil and gas formations.

OIL, GAS OR WATER RECORDS

CASING RECORD

FORMATION	CONTENT	FROM	TO	SIZE	PUT IN	PULLED OUT
Toronto Lime	Water	3850'	3863'			
Lansing-Kansas City	Water	4006'	4320'			
Mississippian	Show gas	4492'	4530'			
KHK	No fluid	4530'	4594'			
Viola	No fluid	4594'	TD			

Describe in detail the manner in which the well was plugged, indicating where the mud fluid was placed and the method or methods used in introducing it into the hole. If cement or other plugs were used, state the character of same and depth placed, from _____ feet to _____ feet for each plug set.

Hole filled with heavy mud from TD to 345'; hulls rolled in sack and Halliburton plug at 345'; 20 sacks common cement mixed and run through drill pipe; placed on top of plug; heavy mud to 40'; hulls rolled in sack and Halliburton plug at 40'; 10 sacks common cement 40' to base of cellar. Finished plugging 11:00 p.m., March 17, 1958.

RECEIVED
STATE CORPORATION COMMISSION

APR 21 1958
04-02-58
CONSERVATION DIVISION
Wichita, Kansas

(If additional description is necessary, use BACK of this sheet)

Name of Plugging Contractor Badger Drilling Company

Address P. O. Box 287, Tulsa, Oklahoma

STATE OF Oklahoma, COUNTY OF Tulsa, ss.

David A. Brierley (employee of owner) or (owner or operator) of the above-described well, being first duly sworn on oath, says: That I have knowledge of the facts, statements, and matters herein contained and the log of the above-described well as filed and that the same are true and correct. So help me God.

(Signature) David A. Brierley

Tulsa, Oklahoma (Address)

SUBSCRIBED AND SWORN TO before me this 1 day of April, 1958

Marie Griener
Notary Public.

MY COMMISSION EXPIRES MARCH 1, 1961

My commission expires _____

PLUGGING
FILE SEC. 15-T-27R.1574
BOOK PAGE 89 LINE 43

NATIONAL ASSOCIATED PETROLEUM COMPANY
 Ritz Building, Tulsa, Oklahoma
 SW-SW-NE, Section 15, T-27S, R-15W
 Pratt County, Kansas
 Earlywine No. 1

0-5	Substructure	3814-3884	Lime
5-9	Cellar	3884-3955	Lime, Shale, Sand
9-65	Surface Soil & Clay	3955-3991	Lime
65-215	Sand	3991-4047	Lime
215-355	Sand & Shale *	4047-4170	Lime
355-900	Red Bed with Shale Streaks	4170-4139	Lime
900-1125	Shale & Shells	4139-4170	Lime
1125-1685	Shells & Shale	4170-4188	Lime
1685-1990	Shale & Shells	4188-4231	Lime
1990-2050	Shale & Lime	4231-4286	Lime
2050-2160	Lime & Shale	4286-4320	Lime
2160-2305	Shale & Lime	4320-4363	Lime
2305-2445	Lime & Shale	4363-4404	Lime
2445-2565	Shale with Lime Streaks	4404-4444	Lime
2565-2665	Lime & Shale	4444-4487	Lime
2665-2790	Shale & Lime	4487-4497	Miss. Lime (Core #1)
2790-2905	Shale & Shells	4497-4511	Miss. Lime
2905-3070	Lime & Shale	4511-4517	Core #1 Miss. Lime
3070-3210	Shale & Lime	4487-4517	Reaming
3210-3260	Shale & Shells	4517-4540	Miss. Lime
3260-3360	Lime & Shale	4540-4545	Miss. Lime
3360-3460	Lime	4545-4564	Kinderhook Shale
3460-3560	Lime	4564-4591	Kinderhook Shale
3560-3645	Lime	4591-4595	Kinderhook Shale
3645-3680	Lime	4595-4617	Viola top - 4597
3680-3720	Lime	4617-4630	Viola Lime T.D. Dry Hole
3720-3814	Lime		

* Run 9 Jts. 8 5/8" Casing,
 set at 355' with 300 sacks cement

I certify the above to be a true and exact copy of the Drillers
 Log as shown by the Daily Drilling Reports.

BADGER DRILLERS, INC.

Subscribed and sworn to before me
 this 31st day of March, 1958

Notary Public Opal Inaluel

My Commission Expires 6-26-60 10-20-61

PLUGGING
 FILE SEC 15-T-27-R-15W
 BOOK PAGE 89 LINE 43

STAMP

COMMISSION DIVISION
 Pratt County, Kansas