

WELL PLUGGING RECORD

Give All Information Completely
Make Required Affidavit
Mail or Deliver Report to:
Conservation Division
State Corporation Commission
211 No. Broadway
Wichita, Kansas

Pratt County, Sec. 15 Twp. 27 Rge. 15 (E) (W)*

Location as "NE/CNW/SW" or footage from lines SE SE NE

Lease Owner J. E. Newman

Lease Name Earlywine Well No. 1

Office Address 2005 Tower Bldg., Denver 2, Colorado

Character of Well (completed as Oil, Gas or Dry Hole) Dry hole

Date well completed May 29, 1963

Application for plugging filed About May 21, 1963

Application for plugging approved About May 26, 1963


Plugging commenced May 28, 1963

Plugging completed May 29, 1963

Reason for abandonment of well or producing formation Dry hole

If a producing well is abandoned, date of last production none 19__

Was permission obtained from the Conservation Division or its agents before plugging was commenced? yes

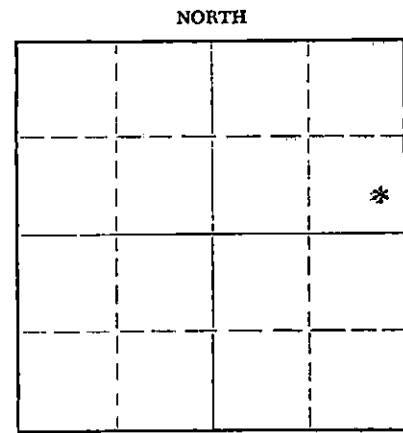

Locate well correctly on above Section Plat

Name of Conservation Agent who supervised plugging of this well Mr. Archie Elving

Producing formation Cherokee sand Depth to top 4432 Bottom 4600 Total Depth of Well 4600 Feet

Show depth and thickness of all water, oil and gas formations. 4439

OIL, GAS OR WATER RECORDS

CASING RECORD

FORMATION	CONTENT	FROM	TO	SIZE	PUT IN	PULLED OUT
Note: Electric log was filed with the plugging application						
				4 1/2" 9.50 pipe	4552'	3517'

Describe in detail the manner in which the well was plugged, indicating where the mud fluid was placed and the method or methods used in introducing it into the hole. If cement or other plugs were used, state the character of same and depth placed, from ___ feet to ___ feet for each plug set.

320' of 8 5/8" surface pipe, cement circulated with 300 sacks. 4552' of 4 1/2" long string, cemented with 200 sacks. Plugged back to 4500'. Perforated 4432' to 39'. Sanded to 4410'. Cemented with 3 sacks. Fluid level was up in hole. Plug was set at 240', 15' rock bridge, cemented through dump bailer with 8 sacks cement with 10% Cal-Seal, let set overnight. Next morning hole bailed down and 12 sacks cement was added to plug. Hole was filled with mud to 40', 10' rock bridge, cemented with 10 sacks to base cellat. 3517' of 4 1/2" long string recovered from hole.

RECEIVED
STATE CORPORATION COMMISSION

JUN 25 1963

CONSERVATION DIVISION
Wichita, Kansas

(If additional description is necessary, use BACK of this sheet)

Name of Plugging Contractor Cherokee Drilling & Exploration

Address Suite 2005 Tower Building, Denver 2, Colorado

STATE OF Kansas, COUNTY OF Pratt, ss.

B. Y. Newman (employee of owner) or (owner or operator) of the above-described well, being first duly sworn on oath, says: That I have knowledge of the facts, statements, and matters herein contained and the log of the above-described well as filed and that the same are true and correct. So help me God.

(Signature) B. Y. Newman
1500 East 1st St Pratt Kansas
(Address)

SUBSCRIBED AND SWORN TO before me this 23 day of June, 1963

My commission expires Feb. 15, 1967

Jandra J. Holzman
Notary Public.

