

STATE OF KANSAS  
STATE CORPORATION COMMISSION


Form CP-4

Give All Information Completely  
Make Required Affidavit  
Mail or Deliver Report to:  
Conservation Division  
State Corporation Commission  
P. O. Box 17027  
Wichita, Kansas 67217  
NORTH

WELL PLUGGING RECORD

Pratt County. Sec. 3 Twp. 28S Rge. 12 (E) W (W)

Location as "NE/CNW/SW" or footage from lines SW SW NE  
Lease Owner Halliburton Oil Producing Co.  
Lease Name Barker Well No. 1  
Office Address 117 Cameron Bldg, Oklahoma City, Oklahoma 73100  
Character of Well (completed as Oil, Gas or Dry Hole) Dry Hole  
Date well completed 10-18 19 72  
Application for plugging filed 10-18 19 72  
Application for plugging approved 10-18 19 72  
Plugging commenced 10-18 19 72  
Plugging completed 10-18 19 72  
Reason for abandonment of well or producing formation Dry Hole

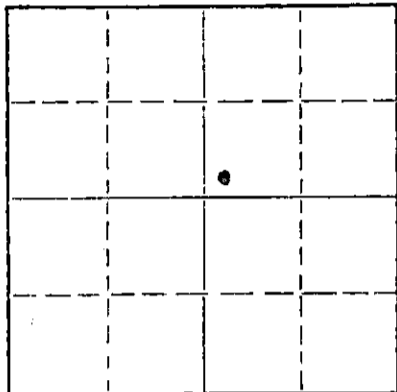

Locate well correctly on above Section Plat

If a producing well is abandoned, date of last production 19  
Was permission obtained from the Conservation Division or its agents before plugging was commenced? Yes

Name of Conservation Agent who supervised plugging of this well Russ Beiberstein  
Producing formation Depth to top Bottom Total Depth of Well Feet  
Show depth and thickness of all water, oil and gas formations.

OIL, GAS OR WATER RECORDS

CASING RECORD

FORMATION	CONTENT	FROM	TO	SIZE	PUT IN	PULLED OUT
Surface pipe		-0-	322	10 3/4	322	None

Describe in detail the manner in which the well was plugged, indicating where the mud fluid was placed and the method or methods used in introducing it into the hole. If cement or other plugs were used, state the character of same and depth placed, from feet to feet for each plug set.

Plugged with pump truck  
#1 plug set @ 300' with 50 sks. cement.  
#2 plug set @ 40' with 15 sks. cement.  
#3 plug set in rat hole with 5 sks. cement.


RECEIVED  
STATE CORPORATION COMMISSION  
OCT 24 1972  
CONSERVATION DIVISION  
Wichita, Kansas

(If additional description is necessary, use BACK of this sheet)

Name of Plugging Contractor Sweetman Drilling, Inc.  
Address Box 645, Great Bend, Kansas 67530

STATE OF Kansas, COUNTY OF Barton, ss.  
Gary L. Hawk (employee of owner) or (owner or operator) of the above-described well, being first duly sworn on oath, says: That I have knowledge of the facts, statements, and matters herein contained and the log of the above-described well as filed and that the same are true and correct. So help me God.

(Signature) Gary L. Hawk  
Box 645, Great Bend, Kansas 67530  
(Address)

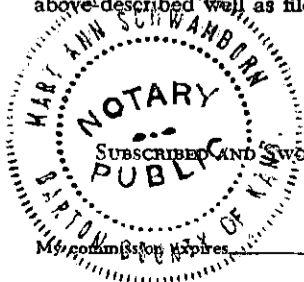

SUBSCRIBED AND SWORN TO before me this 23rd day of October, 1972

Mary Ann Schwamborn  
Notary Public.

WELL LOG  
Barker #1  
SW SW NE 3-28S-12W  
Pratt County, Kansas

Name of Operator: Halliburton Oil Producing Co.  
117 Cameron Bldg.  
Oklahoma City, Oklahoma 73100

Date Completed: October 18, 1972

<u>FROM</u>	<u>TO</u>	
0	200	Sand
200	1352	Red bed and shale
1352	1727	Shale
1727	3751	Shale and lime
3751	4470	Lime
4470		Total Depth

RECEIVED  
STATE CORPORATION COMMISSION  
OCT 24 1972  
CONSERVATION DIVISION  
Wichita, Kansas

STATE OF KANSAS

COUNTY OF BARTON ss

Gary L. Hawk, Secretary of Sweetman Drilling, Inc., being first duly sworn on oath says: That I have knowledge of the facts, statements and matters herein contained and the log of the above described well as filed and that the same are true and correct.

Gary L. Hawk  
Gary L. Hawk

Subscribed and sworn before me this 23rd day of October, 1972.

Mary Ann Schwaborn  
Notary Public Barton County

My Commission Expires 7-10-73

