

STATE CORPORATION COMMISSION OF KANSAS
OIL & GAS CONSERVATION DIVISION

WELL COMPLETION OR RECOMPLETION FORM
ACO-1 WELL HISTORY

API NO. 15-191-21,739-0000

County... Sumner

125' W of C.E./2.S.E. NE. Sec... 9 Twp. 35S Rge... 2 East West

DESCRIPTION OF WELL AND LEASE

Operator: License # 5673
Name W. L. Kirkman, Inc.
Address 453 S. Webb Road
P.O. Box 18611
City/State/Zip Wichita, KS 67218

3365..... Ft North from Southeast Corner of Section
453..... Ft West from Southeast Corner of Section
(Note: Locate well in section plat below)

Lease Name..... Weber Well # 2

Field Name..... Alton

Purchaser..... Koch Oil Company
Wichita, Kansas

Producing Formation..... Simpson

Operator Contact Person Wayne L. Kirkman
Phone 316-685-5372

Elevation: Ground..... 1119 KB..... 1128

Contractor: License # 5829
Name Aldebaran Drilling Co., Inc.


Wellsite Geologist L. Kristopher Moore
Phone 316-685-5372

Designate Type of Completion
 New Well Re-Entry Workover

Oil SWD Temp Abd
 Gas Inj Delayed Comp.
 Dry Other (Core, Water Supply etc.)

If OWNO: old well info as follows:
Operator.....
Well Name.....
Comp. Date..... Old Total Depth.....

Section Plat

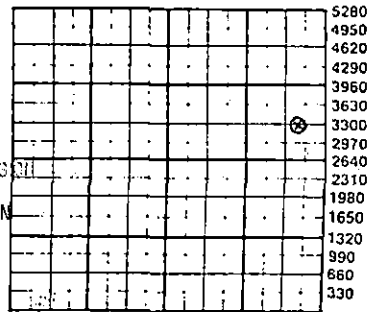

WATER SUPPLY INFORMATION
Disposition of Produced Water: Disposal Repressuring
Docket #

WELL HISTORY

Drilling Method:
 Mud Rotary Air Rotary Cable
8-30-84 9-10-84 11-26-84
Spud Date Date Reached TD Completion Date
4963' 4719
Total Depth PBTD

Questions on this portion of the ACO-1 call:
Water Resources Board (913) 296-3717
Source of Water:
Division of Water Resources Permit #.....
 Groundwater..... Ft North from Southeast Corner (Well) Ft West from Southeast Corner
Sec Twp Rge East West
 Surface Water..... Ft North from Southeast Corner (Stream, pond etc)..... Ft West from Southeast Corner
Sec Twp Rge East West
 Other (explain).....
(purchased from city, R.W.D. #)


INSTRUCTIONS: This form shall be completed in duplicate and filed with the Kansas Corporation Commission, 200 Colorado Derby Building, Wichita, Kansas 67202, within 90 days after completion or recompletion of any well. Rule 82-3-130 and 82-3-107 apply. Information on side two of this form will be held confidential for a period of 12 months if requested in writing and submitted with the form. See rule 82-3-107 for confidentiality in excess of 12 months. One copy of all wireline logs and drillers time log shall be attached with this form. Submit CP-4 form with all plugged wells. Submit CP-111 form with all temporarily abandoned wells.

All requirements of the statutes, rules and regulations promulgated to regulate the oil and gas industry have been fully complied with and the statements herein are complete and correct to the best of my knowledge.

Signature L. Kristopher Moore
Title..... Geologist Date 1-15-85

Subscribed and sworn to before me this 15th day of January 19.. 85.
Notary Public Kathleen G. Quinn
Kathleen G. Quinn

Date Commission Expires March 20, 1987

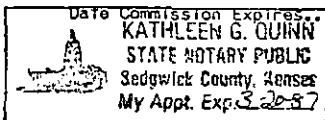

K.C.C. OFFICE USE ONLY
F Letter of Confidentiality Attached
C Wireline Log Received
C Drillers Time Log Received
Distribution
 KCC SWD/Rep NGPA
 KGS Plug Other (Specify)

Sec. 9 Twp. 35S Rge. 2W