

STATE OF KANSAS
STATE CORPORATION COMMISSION

Form CP-4

Give All Information Completely
Make Required Affidavit
Mail or Deliver Report to:
Conservation Division
State Corporation Commission
212 No. Market
Wichita, Kansas

WELL PLUGGING RECORD

Stevens County, Sec. 25 Twp. 34S Rge. (E) 38-(W)

Location as "NE/CNW/SW" or footage from lines C-NW-NW

Lease Owner LVO Corporation

Lease Name ELLIOTT Well No. 1

Office Address P. O. Box 2848, Tulsa, Oklahoma 74101

Character of Well (completed as Oil, Gas or Dry Hole) DH

Date well completed January 25, 19 70

Application for plugging filed January 25, 19 70

Application for plugging approved January 25, 19 70


Plugging commenced January 25, 19 70

Plugging completed January 25, 19 70

Reason for abandonment of well or producing formation

If a producing well is abandoned, date of last production 19

Was permission obtained from the Conservation Division or its agents before plugging was commenced? yes

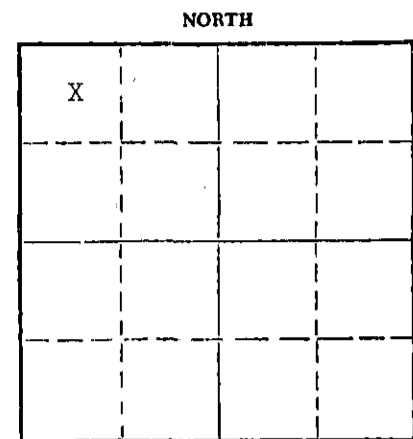

Locate well correctly on above Section Plat

Name of Conservation Agent who supervised plugging of this well

Producing formation Depth to top Bottom Total Depth of Well 7830 Feet

Show depth and thickness of all water, oil and gas formations.

OIL, GAS OR WATER RECORDS

CASING RECORD

FORMATION	CONTENT	FROM	TO	SIZE	PUT IN	PULLED OUT
		0	171.7'	8 5/8"	171.7'	

Describe in detail the manner in which the well was plugged, indicating where the mud fluid was placed and the method or methods used in introducing it into the hole. If cement or other plugs were used, state the character of same and depth placed, from feet to feet for each plug set.

35 sx. @1200'
15 sx. 40' - 0'

RECEIVED
STATE CORPORATION COMMISSION
FEB 3 1970
CONSERVATION DIVISION
Wichita, Kansas

(If additional description is necessary, use BACK of this sheet)
Name of Plugging Contractor Zenith Drilling Corporation, Inc.
Address Suite 737 - 300 West Douglas, Wichita, Kansas

STATE OF Kansas, COUNTY OF Sedgwick, ss.

C. Robert Buford (employee of owner) of the above-described well, being first duly sworn on oath, says: That I have knowledge of the facts, statements, and matters herein contained and the log of the above-described well as filed and that the same are true and correct. So help me God.

(Signature) C. Robert Buford
Suite 737 - 300 West Douglas (Address)

SUBSCRIBED AND SWORN TO before me this 30th day of January, 19 70.

My commission expires August 15, 1971. Myrna S. Murphy Notary Public.