


STATE OF KANSAS  
STATE CORPORATION COMMISSION  
Give All Information Completely  
Make Required Affidavit  
Mail or Deliver Report to:  
Conservation Division  
State Corporation Commission  
800 Bitting Building  
Wichita, Kansas

WELL PLUGGING RECORD  
OR  
FORMATION PLUGGING RECORD

Strike out upper line  
when reporting plug-  
ging off formations.

NORTH

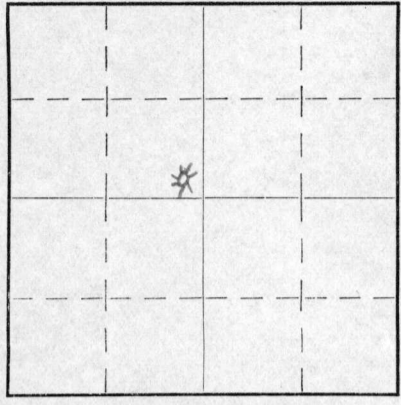

Locate well correctly on above  
Section Plat

Stevens County, Sec. 16 Twp. 34 Rge. 38 (E) (W)

Location as "NE 1/4 NW 1/4 SW 1/4" or footage from lines  
Lease Owner Panhandle Eastern Pipe Line Co.  
Lease Name Kelley Well No. 1  
Office Address 1221 Baltimore Avenue, Kansas City, Mo.  
Character of Well (Completed as Oil, Gas or Dry Hole)  
Date, well completed April 1931  
Application for plugging filed April 1931  
Application for plugging approved April 7 File no. 113-30 1934  
Plugging Commenced July 24 1935  
Plugging Completed Aug 9 1935  
Reason for abandonment of well or producing formation Bad casing  
If a producing well is abandoned, date of last production April 1933  
Was permission obtained from the Conservation Division or its agents before plugging was commenced?

Name of Conservation Agent who supervised plugging of this well T. J. Phillippe  
Producing formation Winfield + Ft. Riley Depth to top 2690 Bottom 2785 Total Depth of Well 2815 Feet.  
Show depth and thickness of all water, oil and gas formations.

~~OIL~~ GAS OR WATER RECORDS

CASING RECORD

Formation	Content	From	To	Size	Put In	Pulled Out
		2690'		12 1/2"	610'	None
		2715'		5 3/16"	2651'	None
		2745'				
		2785'				

Describe in detail the manner in which the well was plugged, indicating where the mud fluid was placed and the method or methods used in introducing it into the hole. If cement or other plugs were used, state the character of same and depth placed, from \_\_\_\_\_ feet to \_\_\_\_\_ feet for each plug set.

Well was plugged back to 2687' with 75 sacks of cement in September 1943.

Ran 77 sacks of cement which plugged back to 2651 ft, this cementing was completed August 1-1945.

plugged back to 2603 ft with rock + six sacks of cement Aug 20-1945

Put in bridge at 2180 ft, filled up to 2170 ft with rock + mud and run 2 sacks of cement

10 ft of rock and 4 sacks of cement applied to cement set filled hole mud to ground elevation

Took 6 ft of 5316 out and capped with five sacks of cement

Pipe 5316 was cemented with 30 sacks when pipe was run, on April 27 1943 Ran 75 sack of cement through split joint, on May 6 1943 shot pipe at 1956 and cemented with 35 sacks

(If additional description is necessary, use BACK of this sheet)

Correspondence regarding this well should be addressed to Panhandle Eastern Pipe Line Co.  
Address 1221 Baltimore Avenue Kansas City, Mo.

STATE OF Kansas COUNTY OF Stevens, ss.  
S. H. Neithcoat (employee of owner) or (owner or operator) of the above-described well,  
being first duly sworn on oath, says: That I have knowledge of the facts, statements, and matters herein contained and the log of the above-described well as filed and that the same are true and correct. So help me God.


(Signature) S. H. Neithcoat

Heegotore, Mo. (Address)

SUBSCRIBED AND SWORN to before me this 30 day of Aug 1945

My commission expires May 11, 1947

rec'd 8-31-45

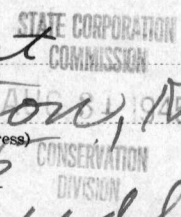

Notary Public.

WELL LOG

KELLEY WELL NW $\frac{1}{4}$  SECTION 16-34-38 STEVENS COUNTY, KANSAS

ELEVATION 3258' COMMENCED 11-24-30 COMPLETED 4-4-31

15	Sandy Soil	145	28	Shale & Anhydrite	2527	
100	Yellow Clay	160	40	Slate, Anhydrite, Shale	2567	
42	Quick Sand	260	131	Lime and Shale	2698	
42	Red Rock & Sand	302	2	Lime	2700	1st Gas 2690
80	Red Rock & Sand	382	35	Sandy Lime & Shale	2735	Gas 2715
25	Clay & Gravel	407	20	Sandy Lime	2755	Gas 2745 & 2755
15	Sand	422	20	Lime (Inc. gas)	2775	
25	Clay & Quick Sand	447	34	Lime & Shale	2809	Gas 2785
30	Clay & Red Rock	477	30	Red Rock	2839	
32	River Sand	509	38	Lime	2877	Gas. 2830-60
20	Yellow Mud	529				
5	Quick Sand	534				
32	Yellow Mud	566		T.D.	2877	
25	Sand	591				
130	Red Rock	721				
15	Gyp Sand	736		<u>VOLUME</u>	3,844,000	
25	Red Rock & Sand	761		R. P.	432#	
95	Red Rock	856				
115	Red Rock & Sand	971		<u>CASING RECORD</u>		
10	Water Sand	981				
35	Broken Gyp	1016				
42	Red Bed, Sand & Gyp	1058				
11	Lime	1069				
15	Red Rock	1084		12 $\frac{1}{2}$ "	Set 234'	Pulled
115	Lime	1199		10"	555'	
32	Red Beds	1231		8 $\frac{1}{2}$ "	1290'	700'
29	Broken Gyp	1260		6-5/8"	1745'	600'
20	White Water Sand	1280		5-3/16"	2182'	
220	Sand, Lime & Red Bed	1500				
24	Broken Lime	1524				
106	Red Beds	1630				
60	Broken Lime & Shells	1690				
20	Water Sand	1710				
54	Red Bed	1764				
55	Gyp & Red Beds	1819				
95	Red Beds, Broken & Sandy Lime	1914				
116	Gyp Shells, Red Beds & Sand	2030				
8	Shale	2038				
65	Lime, Shale & Shell	2103				
40	Sandy Lime & Sticky Shale	2143				
22	Hard Red Beds	2165				
70	Gyp, Lime & Shale	2235				
70	Sandy Lime & Hard Red Beds	2305				
35	Broken Lime & Red Bed	2340				
40	Sticky Shale & Lime	2380				
22	Gyp, Lime & Shale	2402				
12	Anhydrite	2414				
35	Shale & Anhydrite	2449				
40	Anhydrite, Shale & Lime	2489				
10	Gyp	2499				

**PLUGGING**  
 FILE 16-34-38W  
 BOOK PAGE 113 LINE 30