


STATE OF KANSAS
STATE CORPORATION COMMISSION
200 Colorado Derby Bldg.
Wichita, Kansas 67202

Form CP-4
Rev. 12-15-80

WELL PLUGGING RECORD

Give All Information Completely
Make Required Affidavit

COUNTY Stevens SEC. 22 TWP. 34S RGE. 39W E/W
Location as in quarters or footage from lines:
150' from S line of section: 2170' from W line of section

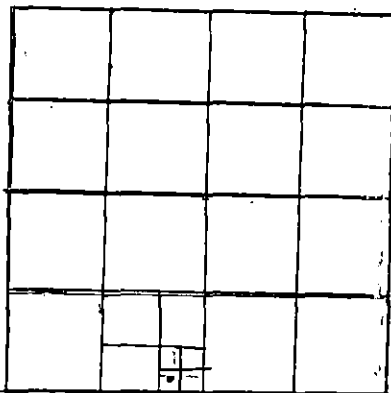

Locate Well
correctly on above
Section Platt.

Lease Owner Tom F. Marsh, Inc.
Lease Name Cunningham Well No. 1-A
Office Address P.O. Box 1869, Liberal, KS 67901
Character of Well (Completed as Oil, Gas or Dry Hole): Dry:
Date Well Completed N/A Abandoned due to cave in
Application for plugging filed 12-2-82
Plugging commenced 12-2-82
Plugging completed 12-2-82
Reason for abandonment of well or producing formation Cave in

Was permission obtained from the Conservation Division or it's
Agent's before plugging was commenced? yes

Name of Conservation Agent who supervised plugging of this well Clarence Thomas, Jr.
Producing formation Council Grove Depth to top bottom T.D. 1438'
Show depth and thickness of all water, oil and gas formations.

OIL, GAS OR WATER RECORDS

Casing Record

Formation	Content	From	To	Size	Put in	Pulled Out
				8-5/8"	616'	none

Describe in detail the manner in which the well was plugged, indicating where the mud fluid was placed and the method or methods used in introducing it into the hold. If cement or other plugs were used, state the character of same and depth placed, from feet to feet for each plug set. Plugged with 70 sacks 50/50 POZ, 4% gel, 3% cc @ 1000' & 40 sacks @ 600' - Top of hole with 10 sacks, 10 sacks in rathole

RECEIVED
STATE CORPORATION COMMISSION

DEC 7 1982

CONSERVATION DIVISION
Wichita, Kansas

(If additional description is necessary, use BACK of this sheet)

Name of Plugging Contractor Halliburton, Liberal, KS 67901

STATE OF Kansas COUNTY OF Seward, ss.
R.F. Burke (employee of owner) or (owner or operator) of the
above-described well, being first duly sworn on oath, says: That I have knowledge of the
facts, statements, and matters herein contained and the log of the above-described well as
filed and that the same are true and correct. So help me God.

(Signature) R.F. Burke R.F. Burke
P.O. Box 1869, Liberal, KS 67901
(Address)

SUBSCRIBED AND SWORN TO before me this 2nd day of December, 19 82

Denise Geist
Notary Public.

My Commission expires: 2-26-83

