


STATE OF KANSAS
STATE CORPORATION COMMISSION

Form CP-4

Give All Information Completely
Make Required Affidavit
Mail or Deliver Report to:
Conservation Division
State Corporation Commission
211 No. Broadway
Wichita, Kansas

WELL PLUGGING RECORD

NORTH

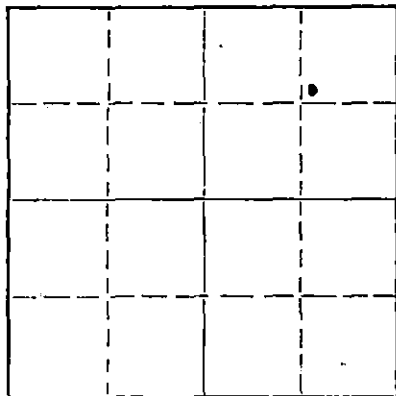

Locate well correctly on above
Section Plat

Morton County, Sec. 19 Twp. 34 Rge. 39 (E) W (W)
Location as "NE/CNW/SW" or footage from lines NE/4
Lease Owner Mobil Oil Corporation
Lease Name Elijah D. Thompson Well No. 1
Office Address P.O. Box 5444 - Terminal Annex, Denver, Colorado 80217
Character of Well (completed as Oil, Gas or Dry Hole) Dry Hole
Date well completed 11-16-79 19 79
Application for plugging filed 19
Application for plugging approved 19
Plugging commenced 11-16-79 19 79
Plugging completed 11-16-79 19 79
Reason for abandonment of well or producing formation Dry Hole
If a producing well is abandoned, date of last production 19
Was permission obtained from the Conservation Division or its agents before plugging was commenced? Yes

Name of Conservation Agent who supervised plugging of this well
Producing formation Depth to top Bottom Total Depth of Well 1454 Feet
Show depth and thickness of all water, oil and gas formations.

OIL, GAS OR WATER RECORDS

CASING RECORD

FORMATION	CONTENT	FROM	TO	SIZE	PUT IN	PULLED OUT
				8 5/8	772'	None

Describe in detail the manner in which the well was plugged, indicating where the mud fluid was placed and the method or methods used in introducing it into the hole. If cement or other plugs were used, state the character of same and depth placed, from feet to feet for each plug set.

Set Plug @ 876' with 50 sacks cement
Set Plug @ 680' with 50 sacks cement
Set plug @ 50' with 20 sacks cement
Set Plug in rat hole with 5 sacks cement

RECEIVED
STATE CORPORATION COMMISSION

APR 28 1980 4-28-80

CONSERVATION DIVISION
WICHITA, KANSAS

(If additional description is necessary, use BACK of this sheet)
Name of Plugging Contractor Earl F. Wakefield, Inc.
Address 300 West Douglas, Suite 500, Wichita, Kansas 67202

STATE OF Colorado, COUNTY OF Denver, ss.
C.J. Park (employee of owner) or (owner or operator) of the above-described well, being first duly sworn on oath, says: That I have knowledge of the facts, statements, and matters herein contained and the log of the above-described well as filed and that the same are true and correct. So help me God

(Signature) C.J. Park

P.O. Box 5444, Denver, CO 80217
(Address)

SUBSCRIBED AND SWORN to before me this 24th day of April, 1980

My Commission expires October 26, 1981

My commission expires

Notary Public.

State of Kansas



JOHN CARLIN
R. C. LOUX
JANE T. ROY
WILLIAM G. GRAY
JAMES B. DOUGLAS

Governor
Chairman
Commissioner
Commissioner
Executive Secretary

State Corporation Commission

CONSERVATION DIVISION

(Oil, Gas and Water)
245 North Water
WICHITA, KANSAS 67202

November 29, 1979

WELL PLUGGING AUTHORITY

Well No. 1
Lease E.D. Thompson Unit
Description NE
Section 19-34S-39W
County Morton
Total Depth 1454'
Plugging Contractor Earl Wakefield, Inc. &
HOWCO

Mobil Oil Corporation
P.O. Box 5444
Denver, Colorado 80217

Gentlemen:

This is your authority to plug the above subject well in accordance with the Rules and Regulations of the State Corporation Commission.

This authority is void after ninety (90) days from the above date.

Yours very truly,

J. Lewis Brock,
Administrator

Mr. Duane L. Rankin, Box 967, Great Bend, Kansas 67530 is hereby assigned to supervise the plugging of the above named well.