

CARD MUST BE TYPED

State of Kansas
NOTICE OF INTENTION TO DRILL
(see rules on reverse side)

CARD MUST BE SIGNED

Starting Date: August 18, 1984
month day year 1130

API Number 15-151-21,470-00-00

OPERATOR: License # 5046
Name Raymond Oil Company, Inc.
Address One Main Place, Suite 900
City/State/Zip Wichita, Kansas 67202
Contact Person Pat Raymond
Phone 316/267-4214

C NE SE Sec. 35 Twp 28 S, Rge 12
(location) 1980 Ft North from Southeast Corner of Section
660 Ft West from Southeast Corner of Section
(Note: Locate well on Section Plat on reverse side)

CONTRACTOR: License # 5829
Name Aldebaran Drilling Co.
City/State Wichita, Kansas 67207

Nearest lease or unit boundary line 660 feet.
County Pratt
Lease Name Rolf Well# 2

Well Drilled For: Well Class: Type Equipment:
 Oil Swd Infield Mud Rotary
 Gas Inj Pool Ext. Air Rotary
 OWWO Expl Wildcat Cable

Domestic well within 330 feet: yes no
Municipal well within one mile: yes no

If OWWO: old well info as follows:

Operator
Well Name
Comp Date Old Total Depth
Projected Total Depth 4700 feet
Projected Formation at TD Arbuckle
Expected Producing Formations Arbuckle & Simpson

Depth to Bottom of fresh water 230 feet
Lowest usable water formation Permian
Depth to Bottom of usable water 250 feet
Surface pipe by Alternate: 1 2
Surface pipe to be set 300 feet
Conductor pipe if any required none feet
Ground surface elevation 1862 feet MSI
This Authorization Expires 2-17-85
Approved By 8-17-84

I certify that we will comply with K.S.A. 55-101, et seq., plus eventually plugging hole to K.C.C. specifications.

Raymond Oil Company, Inc.

Date 8-17-84 Signature of Operator or Agent

Pat Raymond

Vice President

MHC/KDHE 8/17/84


RECEIVED
STATE CORPORATION COMMISSION

Must be filed with the K.C.C. five (5) days prior to commencing well
This card void if drilling not started within six (6) months of date received by K.C.C.

AUG 17 1984

CONSERVATION DIVISION

Wichita, Kansas
A Regular Section of Land
1 Mile = 5,280 Ft.

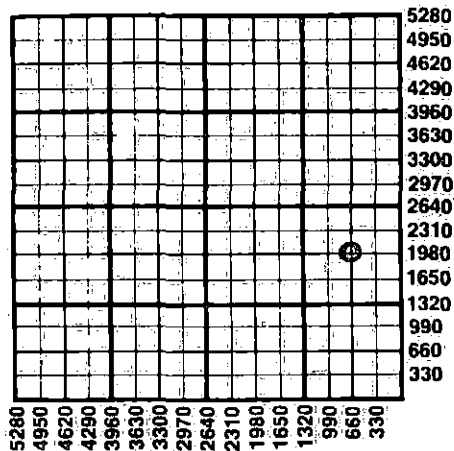

Important procedures to follow:

1. Notify District office before setting surface casing.
2. Set surface casing by circulating cement to the top.
3. File completion forms ACO-1 with K.C.C. within 90 days of well completion, following instructions on ACO-1, side 1, and including copies of wireline logs.
4. Notify District office 48 hours prior to old well workover or re-entry.
5. Prior to plugging, prepare a plugging plan, then obtain agreement from the appropriate district office for an approved plugging plan.
6. Submit plugging report (CP-4) to K.C.C. after plugging is completed.
7. Obtain an approved injection docket number before disposing of salt water.
8. Notify K.C.C. within 10 days when injection commences or terminates.
9. If an alternate 2 completion, cement in the production pipe from below any usable water to surface within 120 days of spud date.

State Corporation Commission of Kansas
Conservation Division
200 Colorado Derby Building
Wichita, Kansas 67202
(316)263-3238