

CARD MUST BE TYPED

State of Kansas  
**NOTICE OF INTENTION TO DRILL**  
(see rules on reverse side)

CARD MUST BE SIGNED

Starting Date: September 9, 1985  
month day year

API Number 15- 151-21,699-00-00

OPERATOR: License # 5004  
Name Vincent Oil Corporation  
Address 125 N. Market, Suite 1110  
City/State/Zip Wichita, KS 67202  
Contact Person Donna Manda  
Phone 316-262-3573

C NE SW NE (location) Sec 35 Twp 28S S, Rge 12  East  West  
3630 Ft North from Southeast Corner of Section  
1650 Ft West from Southeast Corner of Section  
(Note: Locate well on Section Plat on reverse side)

CONTRACTOR: License # 5149  
Name Wheatstate Oilfield Services  
City/State Wichita, KS 67214

Nearest lease or unit boundary line 330 feet.  
County Pratt  
Lease Name Rolf Well # #1

Well Drilled For: Well Class: Type Equipment:  
 Oil  Swd  Infield  Mud Rotary  
 Gas  Inj  Pool Ext.  Air Rotary  
 OWWO  Expl  Wildcat  Cable

Domestic well within 330 feet:  yes  no  
Municipal well within one mile:  yes  no

If OWWO: old well info as follows:

Operator .....  
Well Name .....  
Comp Date ..... Old Total Depth .....  
Projected Total Depth 4600 feet  
Projected Formation at TD Simpson Sand  
Expected Producing Formations .....

Depth to Bottom of fresh water 100 feet  
Lowest usable water formation Dakota  
Depth to Bottom of usable water 250 feet  
Surface pipe by Alternate: 1  2   
Surface pipe to be set 400 feet  
Conductor pipe if any required N/A feet  
Ground surface elevation applied for feet MSL  
This Authorization Expires 3-3-86  
Approved By P. J. ...

I certify that we will comply with K.S.A. 55-101, et seq., plus eventually plugging hole to K.C.C. specifications.

Date 9-3-85 Signature of Operator or Agent

Richard A. Hiebsch Title  
Richard A. Hiebsch

Vice President

Richard A. Hiebsch


Must be filed with the K.C.C. five (5) days prior to commencing well  
This card void if drilling not started within six (6) months of date received by K.C.C.

RECEIVED  
STATE CORPORATION COMMISSION

A Regular Section of Land  
1 Mile = 5,280 Ft.

SEP 3 1985

CONSERVATION DIVISION  
Wichita, Kansas

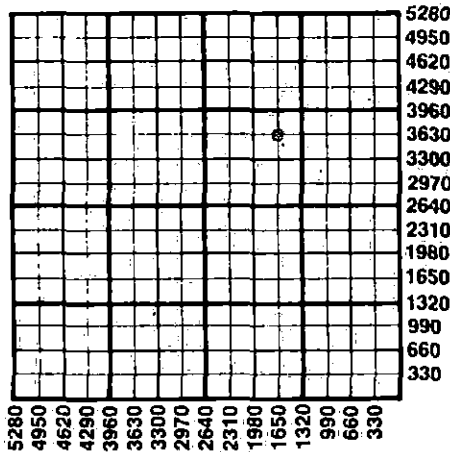

Important procedures to follow :

1. Notify District office before setting surface casing.
2. Set surface casing by circulating cement to the top.
3. File completion forms ACO-1 with K.C.C. within 90 days of well completion, following instructions on ACO-1, side 1, and including copies of wireline logs.
4. Notify District office 48 hours prior to old well workover or re-entry.
5. Prior to plugging, prepare a plugging plan, then obtain agreement from the appropriate district office for an approved plugging plan.
6. Submit plugging report (CP-4) to K.C.C. after plugging is completed.
7. Obtain an approved injection docket number before disposing of salt water.
8. Notify K.C.C. within 10 days when injection commences or terminates.
9. If an alternate 2 completion, cement in the production pipe from below any usable water to surface within 120 days of spud date.

State Corporation Commission of Kansas  
Conservation Division  
200 Colorado Derby Building  
Wichita, Kansas 67202  
(316) 263-3238