

15-189-20017-0000


STATE OF KANSAS
STATE CORPORATION COMMISSION

Form CP-4

Give All Information Completely
Make Required Affidavit
Mail or Deliver Report to:
Conservation Division
State Corporation Commission
212 No. Market
Wichita, Kansas

WELL PLUGGING RECORD

NORTH

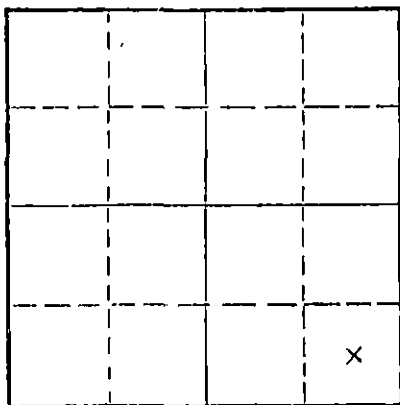

Locate well correctly on above
Section Plat

Stevens County, Sec. 18 Twp. 31S Rge. 35W (E) (W)
Location as "NE/CNW/SW" or footage from lines C-SE-SE
Lease Owner Blaik Oil Company
Lease Name Hinshaw Well No. 1
Office Address 203 Park Avenue, Oklahoma City, Oklahoma
Character of Well (completed as Oil, Gas or Dry Hole) Dry
Date well completed August 11 19 68
Application for plugging filed August 10, 19 68
Application for plugging approved August 10, 19 68
Plugging commenced August 10, 19 68
Plugging completed August 11, 19 68
Reason for abandonment of well or producing formation Dry Hole

If a producing well is abandoned, date of last production 19
Was permission obtained from the Conservation Division or its agents before plugging was commenced? Yes

Name of Conservation Agent who supervised plugging of this well
Producing formation Depth to top Bottom Total Depth of Well 6315' Feet
Show depth and thickness of all water, oil and gas formations.

OIL, GAS OR WATER RECORDS

CASING RECORD

| FORMATION | CONTENT | FROM | TO | SIZE | PUT IN | PULLED OUT |
|-----------|---------|------|-------|--------|--------|------------|
| | | 0 | 1715' | 8 5/8" | | |
| | | | | | | |
| | | | | | | |
| | | | | | | |
| | | | | | | |
| | | | | | | |
| | | | | | | |
| | | | | | | |
| | | | | | | |

Describe in detail the manner in which the well was plugged, indicating where the mud fluid was placed and the method or methods used in introducing it into the hole. If cement or other plugs were used, state the character of same and depth placed, from feet to feet for each plug set.

900' - w/35 sx displaced with mud thru 4 1/2" DP
Filled hole w/mud to 45' below gd. level - set
wooden plug w/hulls, made bridge, mixed 15 sx.
Common - filled to bottom of cellar.

RECEIVED
STATE CORPORATION COMMISSION
SEP 10 1968
CONSERVATION DIVISION
Wichita, Kansas

(If additional description is necessary, use BACK of this sheet)
Name of Plugging Contractor Zenith Drilling Corporation, Inc.
Address Suite 737 - 300 West Douglas, Wichita, Kansas

STATE OF KANSAS, COUNTY OF SEDGWICK, ss.
C. Robert Buford, (employee of owner) or (owner or operator) of the above-described well, being first duly sworn on oath, says: That I have knowledge of the facts, statements, and matters herein contained and the log of the above-described well as filed and that the same are true and correct. So help me God.

(Signature) C. Robert Buford
Suite 737 - 300 W. Douglas, Wichita, Kansas
(Address)

SUBSCRIBED AND SWORN TO before me this 6th day of September, 19 68.

My commission expires August 15, 1971.
Myrna D. Murphy Notary Public.

WELL LOG

COMPANY BLAIK OIL COMPANY

SEC. 18-31S-35W

FARM HINSHAW No. 1

LOC. C-SE-SE


TOTAL DEPTH 6315'

COUNTY Stevens

COMM. July 19, 1968 COMP. August 11, 1968

CONTRACTOR Zenith Drilling Corporation, Inc.

CASING 8 5/8" @1715' w/675 sacks

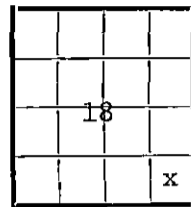

ELEVATION

PRODUCTION D & A

FIGURES INDICATE BOTTOM OF FORMATIONS

| | |
|-----------|---------------------------------|
| 40 | Surface |
| 840 | Sand, Redbed & Anhydrite |
| 1226 | Redbed, Shells, Sand, Anhydrite |
| 1320 | Glor. Sand |
| 1715 | Sand, Redbed & Anhydrite |
| 1955 | Redbed & Shale |
| 2095 | Redbed, shells & shale |
| 2838 | Shale & lime |
| 2920 | Lime |
| 3188 | Shale & lime |
| 3325 | Lime & Shale |
| 3560 | Shale & Lime |
| 3730 | Lime & Shale |
| 4140 | Shale & Lime |
| 4500 | Lime & Shale |
| 4612 | Lime |
| 4790 | Lime & Shale |
| 5385 | Lime |
| 5470 | Lime & shale |
| 5750 | Shale & Lime |
| 6061 | Lime & Shale |
| 6351 T.D. | Lime |

RECEIVED
 STATE CORPORATION COMMISSION
 SEP 10 1968
 CONSERVATION DIVISION
 Wichita, Kansas

State of Kansas }
 County of Sedgwick } ss

I, C. Robert Buford, President of Zenith Drilling Corporation, Inc.

upon oath state the above and foregoing is a true and correct copy of the log of the Hinshaw No. 1 well.

Subscribed and sworn to before me this 6 day of September, 1968.

My Commission Expires: Aug. 15, 1971.

C Robert Buford

Myrna D. Murphy
 NOTARY PUBLIC

Myrna D. Murphy