


STATE OF KANSAS  
STATE CORPORATION COMMISSION

WELL PLUGGING RECORD

Give All Information Completely  
Make Required Affidavit  
Mail or Deliver Report to  
Conservation Division  
State Corporation Comm.  
245 North Water  
Wichita, KS 67202

Seward County, Sec. 15 Twp. 32 Rge. 33 ~~E~~/W  
Location as "NE/CNW $\frac{1}{2}$ SW $\frac{1}{2}$ " or footage from lines  
C SW SW

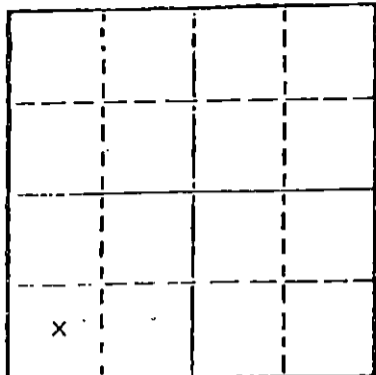

Locate well correctly on above  
Section Plot

Lease Owner Vacca Petroleum Co.  
Lease Name Hattie Jones Well No. 2-15  
Office Address Box 2585, Amarillo, Texas 79105  
Character of Well (Completed as Oil, Gas or Dry Hole) Oil

Date Well completed November 17 1976  
Application for plugging filed March 11 1978  
Application for plugging approved March 13 1978  
Plugging commenced March 16 1978  
Plugging completed March 18 1978

Reason for abandonment of well or producing formation  
100% salt water

If a producing well is abandoned, date of last production  
November 12 1977

Was permission obtained from the Conservation Division or  
its agents before plugging was commenced? Yes

Name of Conservation Agent who supervised plugging of this well Mr. Thomas  
Producing formation Marmaton Depth to top 4262' Bottom 4268' Total Depth of Well 6000'  
Show depth and thickness of all water, oil and gas formations.

OIL, GAS OR WATER RECORDS

CASING RECORD

FORMATION	CONTENT	FROM	TO	SIZE	PUT IN	PULLED OUT
SURFACE		0'	1582'	8 5/8"	1582'	0'
Production		0'	5112'	5 1/2"	5112'	1640'

Describe in detail the manner in which the well was plugged, indicating where the mud fluid was placed and the method or methods used in introducing it into the hold. If cement or other plugs were used, state the character of same and depth placed, from \_\_\_\_\_ feet to \_\_\_\_\_ feet for each plug set.

Cast Iron Bridge Plug set @ 4215' w/ 10' of cement on top.  
Mud 4215' to 1500'  
Spotted 35 sacks cement 1500' to 1400'  
Mud 1400' to 45'  
Put Bridge & 15 sacks cement 45' to 0'  
Cut off 8 5/8" 42" below ground level.

RECEIVED  
STATE CORPORATION COMMISSION

APR 05 1978

CONSERVATION DIVISION  
Wichita, Kansas

(If additional description is necessary, use BACK of this sheet)

Name of Plugging Contractor Midwest Casing Pulling  
Box F, Sublette, Kansas 67877 Kans. Permit # 766

STATE OF KANSAS COUNTY OF Sublette, ss.  
I Edgar J. Eves (employee of owner) or (owner or operator)  
of the above-described well, being first duly sworn on oath, says: That I have knowledge of the facts, statements, and matters herein contained and the log of the above-described well as filed and that the same are true and correct. So help me God.

(Signature)

Edgar J. Eves

Box F, Sublette, Kansas 67877  
(Address)

SUBSCRIBED AND SWORN TO before me this 20 th day of March, 1978

Sondra L. Eves

Notary Public.

My commission expires 12-6-80

